


# PLAT AND RECORD

Of a Survey on Section 6 T 3 R 14 E. of the 4 P. M. in Johnstown Township  
Rock County, Wisconsin, made April the 18 1891

I hereby certify that the following is a correct record of said survey as made by me.

COUNTY BUILDING  
IN CITY OF BELOIT

(Signed) O. G. Bleedorn  
O. G. B. Dep. County Surveyor.

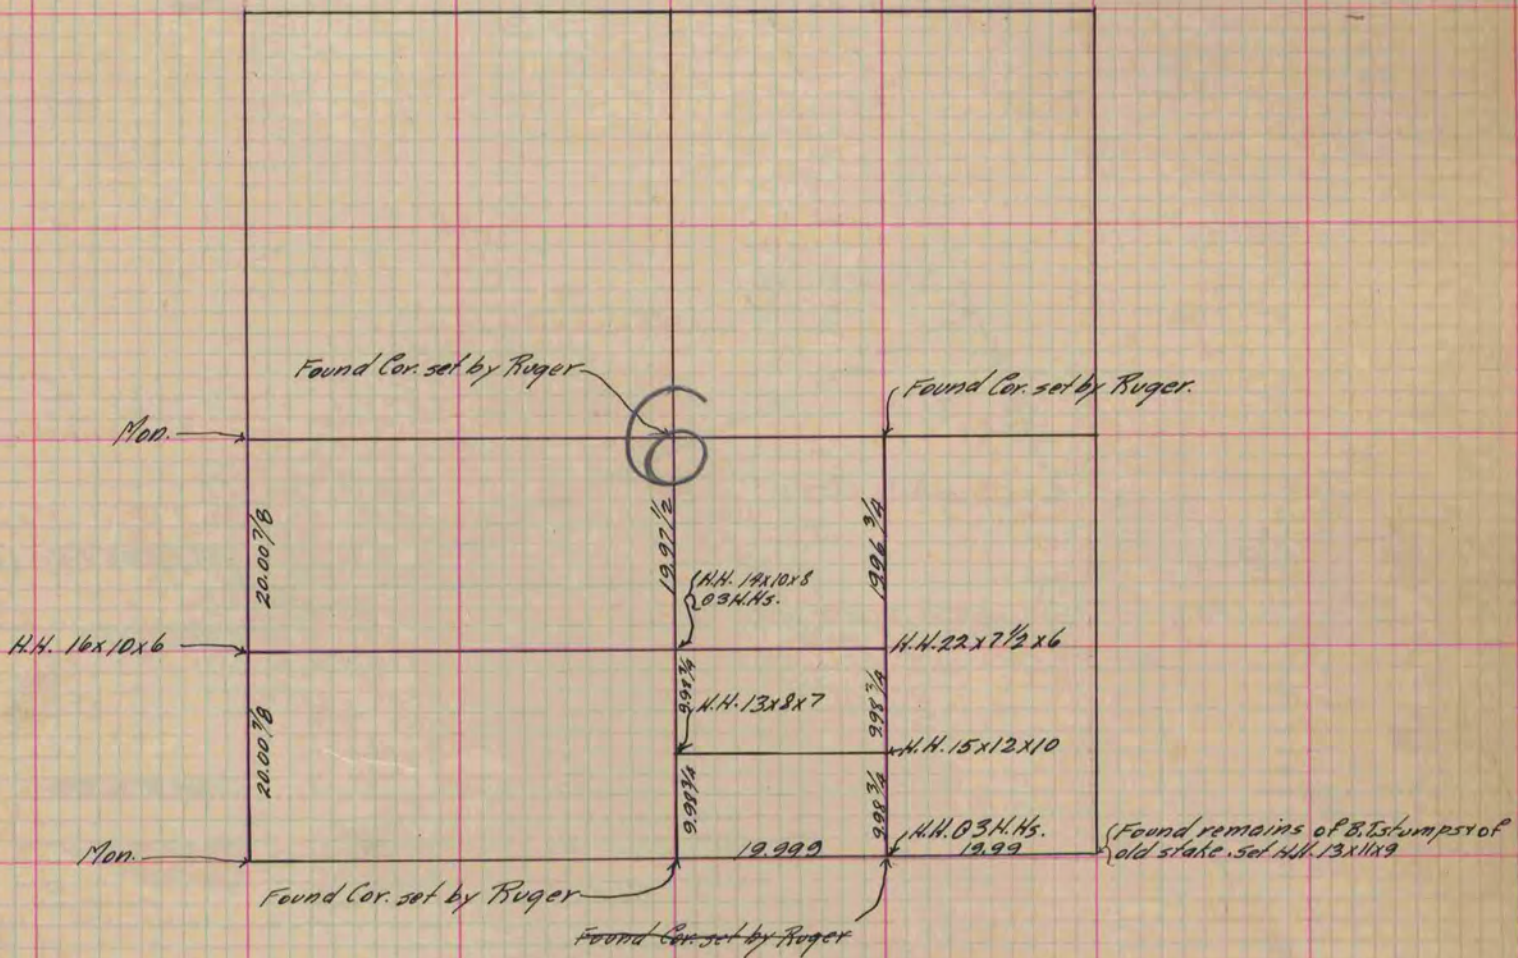

Copied from P. 355 Vol. 2 County Surveyor's Record.