

PLAT AND RECORD

Of a Survey on Section 12 T A R 14 E. of the 4 P. M. in Lima Township


Rock County, Wisconsin, made June the 13 & 14 1876

I hereby certify that the following is a correct record of said survey as made by me.

COUNTY BUILDING
IN CITY OF БЕЛОIT

(Signed) Edward Ruger
R.R.B.

County Surveyor.

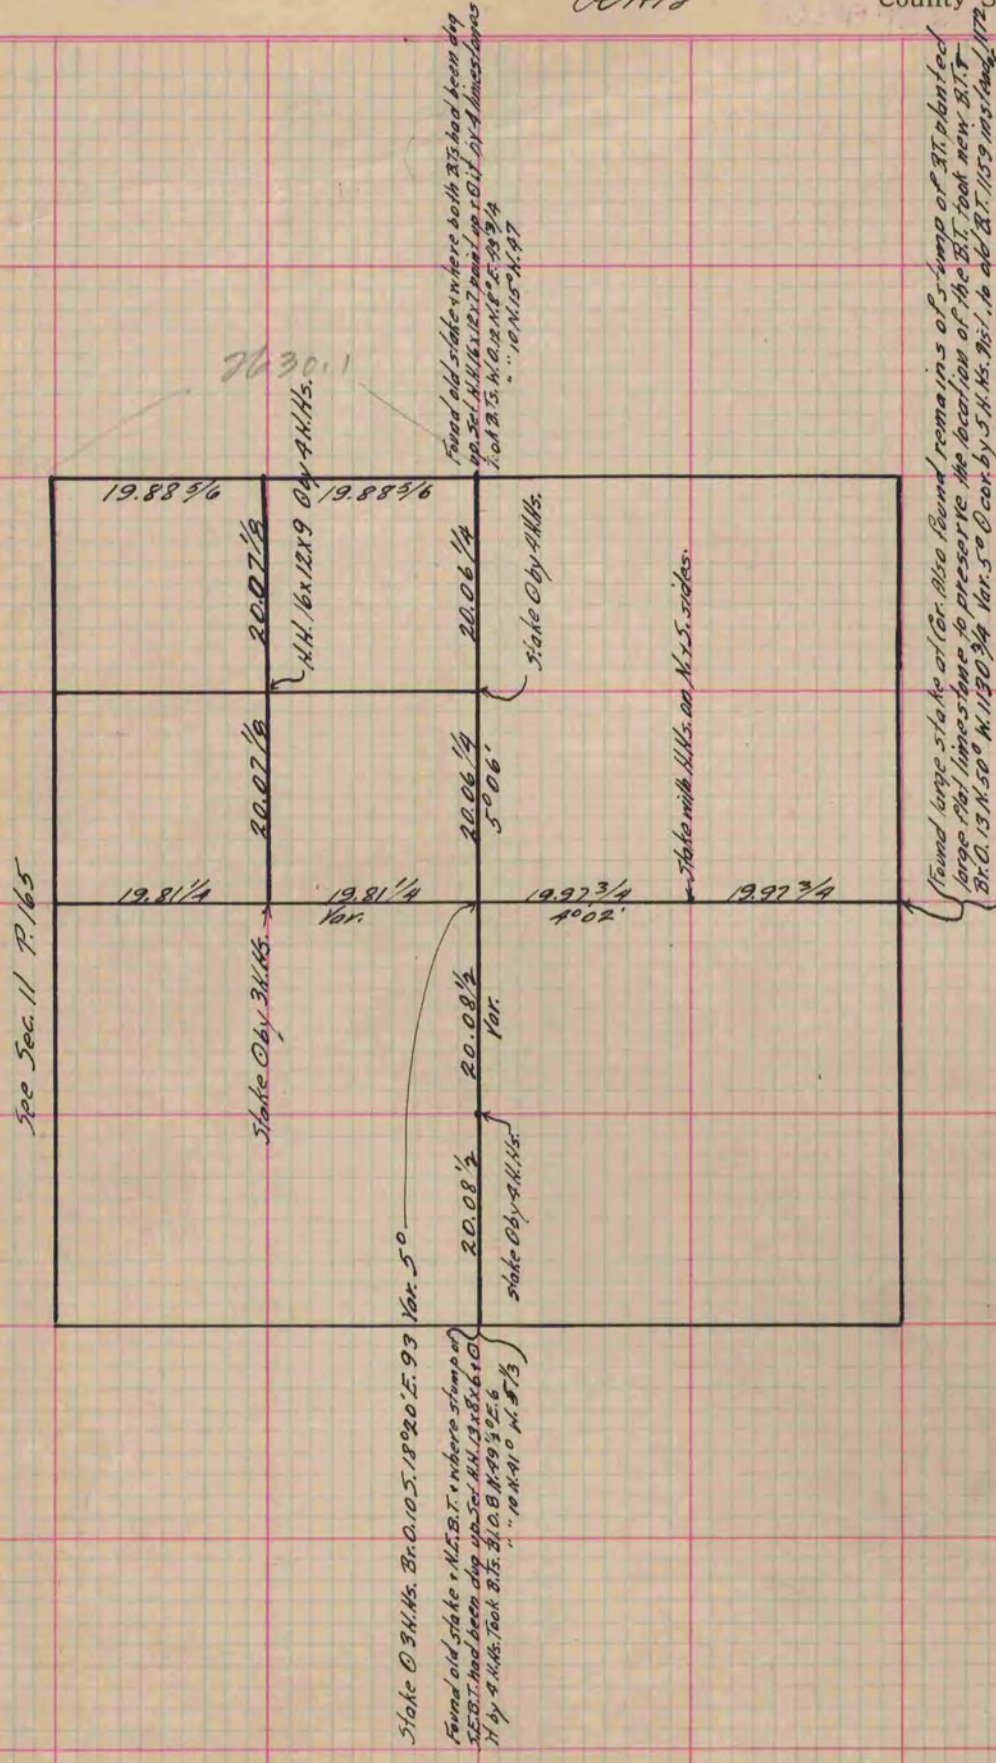

Copied From P. 166 Vol. 2 Original County Surveyor's Record.