

PLAT AND RECORD


Of a Survey on Section 26 T 3 R 14 E. of the 4 P. M. in Johnstown Township

Rock County, Wisconsin, made November the 1st 1864

I hereby certify that the following is a correct record of said survey as made by me.

COUNTY BUILDING
IN CITY OF БЕЛОIT

(Signed) S. D. Locke
S. D. Locke County Surveyor.

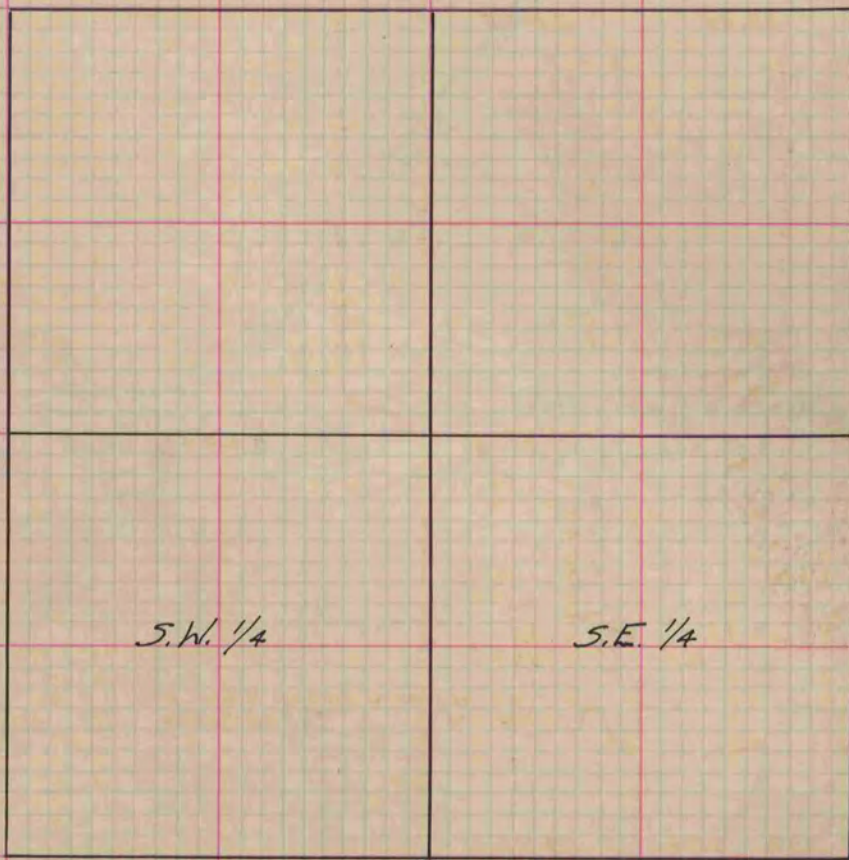

Found old stake set limestone 20x12 x 5 (S. Gr. post)

Copied from lower 1/2 of Page 211 Vol. 1. Original County Surveyor's Record.