

PLAT AND RECORD

113


Of a Survey on Section 25 T 2 R 14 E. of the 4 P. M. in Bradford Township
Rock County, Wisconsin, made October the 7th 1857

I hereby certify that the following is a correct record of said survey as made by me.

COUNTY BUILDING
IN CITY OF БЕЛОIT

(Signed) Edward Ruger.
ER

County Surveyor.

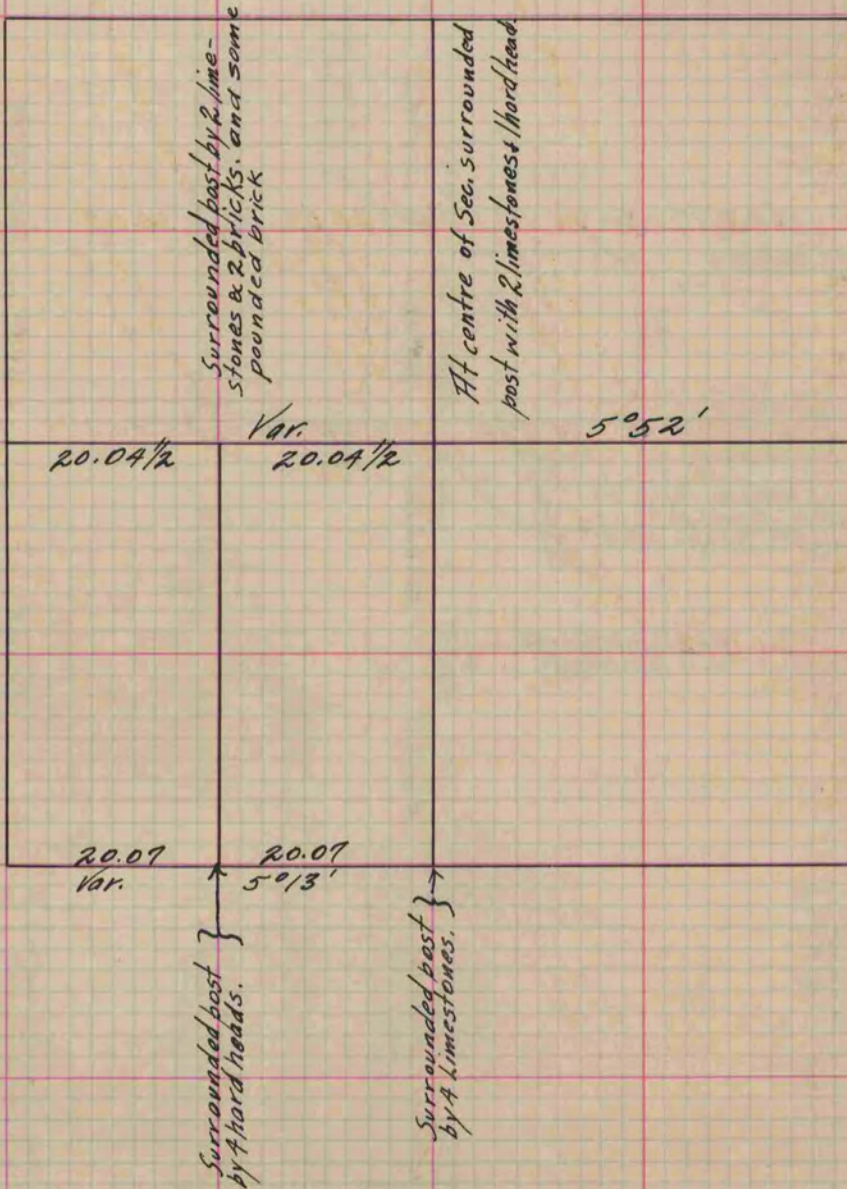

Copied from Page 122 Vol. One Original County Surveyors Record.