

# PLAT AND RECORD

Of a Survey on Section 31 T 3 R 14 E. of the 4 P. M. in Johnstown Township

Rock County, Wisconsin, made APRIL the 8<sup>th</sup> 1969.


I hereby certify that the following is a correct record of said survey as made by me.

COUNTY BUILDING  
IN CITY OF BELOIT

*R. B. Atkinson Jr*

County Surveyor.

THE GEO. S. BARNARD COMPANY, ST. LOUIS

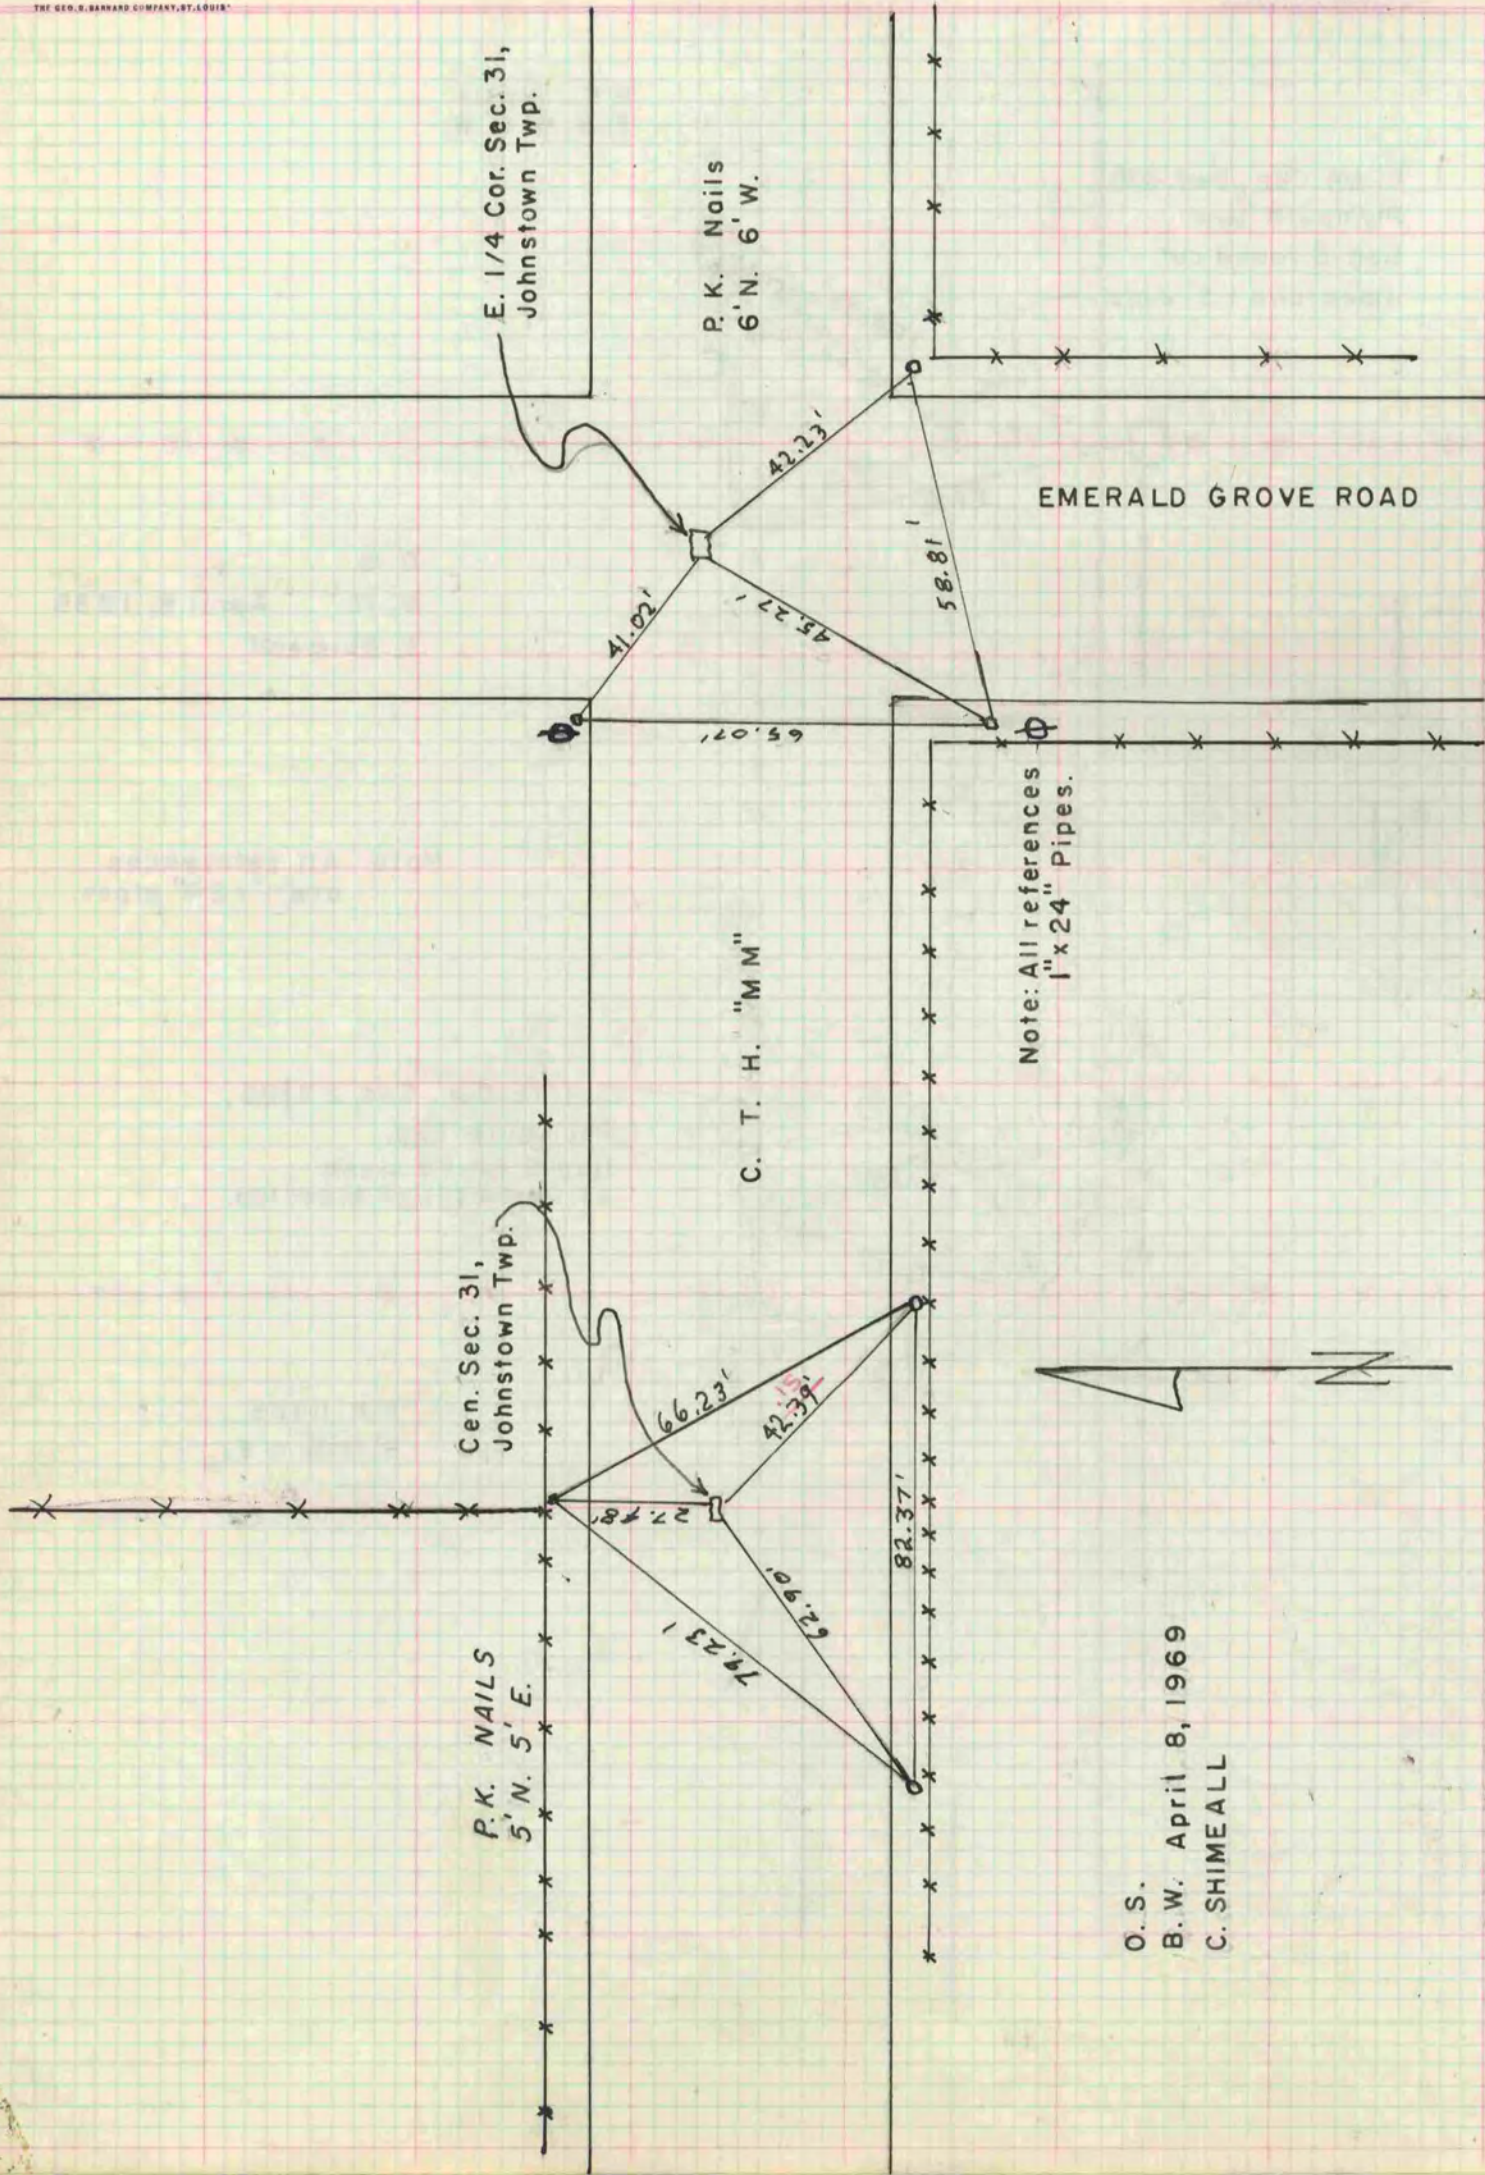

O. S.  
B. W. April 8, 1969  
C. SHIMEALL