

PLAT AND RECORD

343

Of a Survey on Section 35 T IN R 14 E. of the 4 P. M. in CLINTON Township


Rock County, Wisconsin, made SEPTEMBER the 5 1967

I hereby certify that the following is a correct record of said survey as made by me.

R.H. Batten

County Surveyor.

THE GEO. S. BARNARD COMPANY, ST. LOUIS

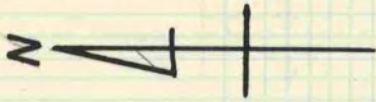


SOMMERVILLE ROAD

NE COR SEC 35

□ "W"

FOUND SMALL H.H. SETTING UP WITH 2 HHS BY IT. PK'S 8' OFFSETS Book 147/1/13

E 1/16 COR SEC 26/35

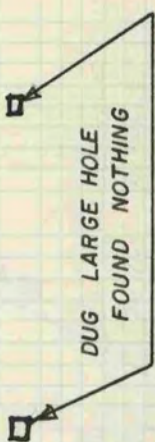

N 1/4 COR SEC 35

NW COR SEC 35

□

DID NOT DIG 6 METAL CULVERT AT COR. C. T. H.

COUNTY BUILDING IN CITY OF BELOIT

PEARSON ROAD

SEPT 5, 1967
H.C.
O.S.