

PLAT AND RECORD

145

Of a Survey on Section 11 T 1 R 10 E. of the 4 P. M. in Avon Township

Rock County, Wisconsin, made June the 25 1874

I hereby certify that the following is a correct record of said survey as made by me.

COUNTY BUILDING
IN CITY OF BELOIT


(Signed) Edward Ruger
1874

County Surveyor.

Found remains of old stake - Also found where stumps of B.T.s. had been dug up }
Drove large Burr. O. stake in place of old stake + oil with several stones.

Drove stake + oil by 6 small stones

Found cor. est. by Louke - Cor. Correct

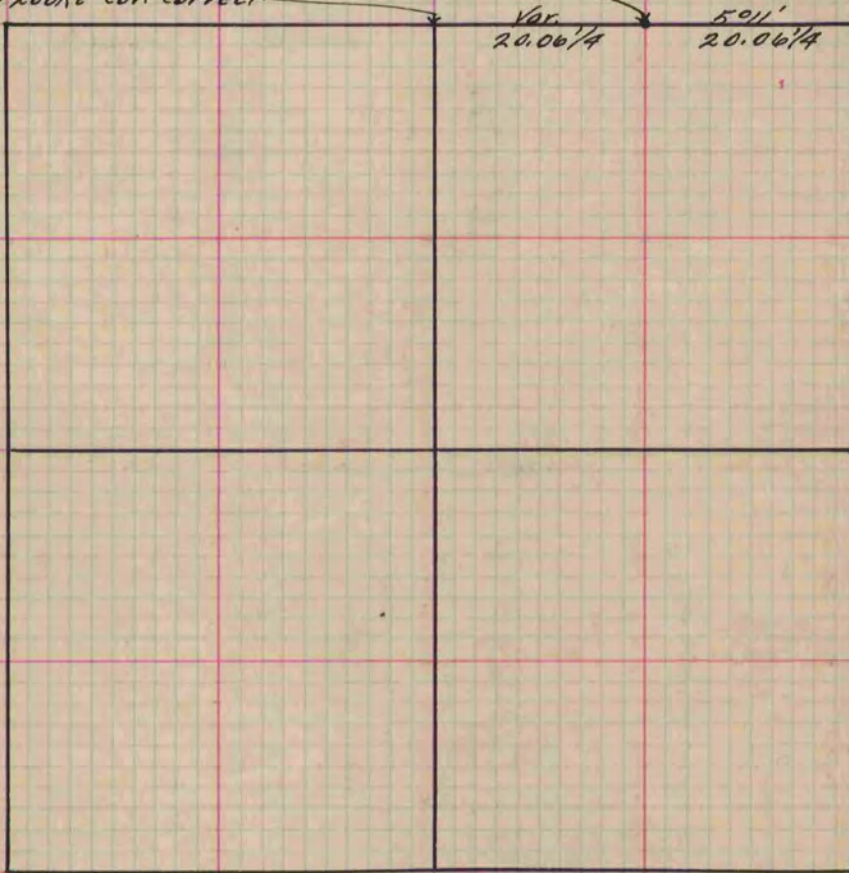

Copied from P102 Vol. 2 Original County Surveyor's Record.