

PLAT AND RECORD


245

Of a Survey on Section 2 T R E. of the 4 P. M. in Rock Township
Rock County, Wisconsin, made the 19

I hereby certify that the following is a correct record of said survey as made by me.

COUNTY BUILDING
IN CITY OF BELOIT

Geo. H. Taylor
County Surveyor.

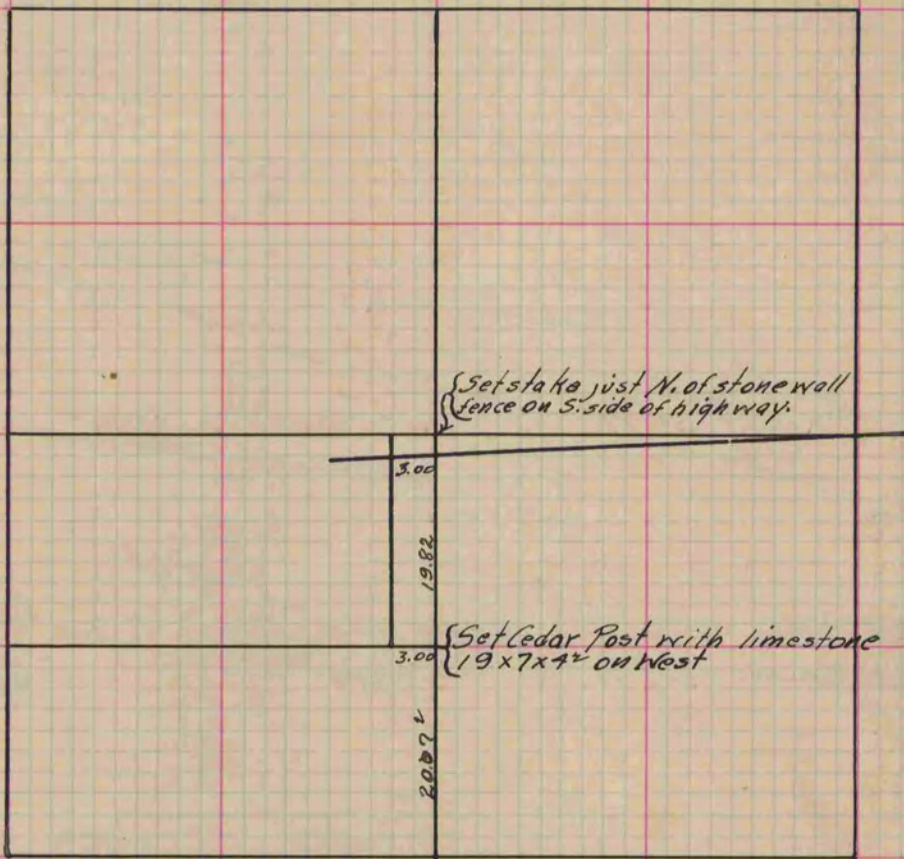

See Next Page For Same

Copied from Page 224 Vol. 1. Original County Surveyor's Record.