

PLAT AND RECORD

133

Of a Survey on Section 33 T 3 R 10 E. of the 4 P. M. in Magnolia Township


Rock County, Wisconsin, made May the 12-13 & 14 1874

I hereby certify that the following is a correct record of said survey as made by me.

COUNTY BUILDING
IN CITY OF БЕЛОIT

(Signed) Edward Ruger
RUGER

County Surveyor.

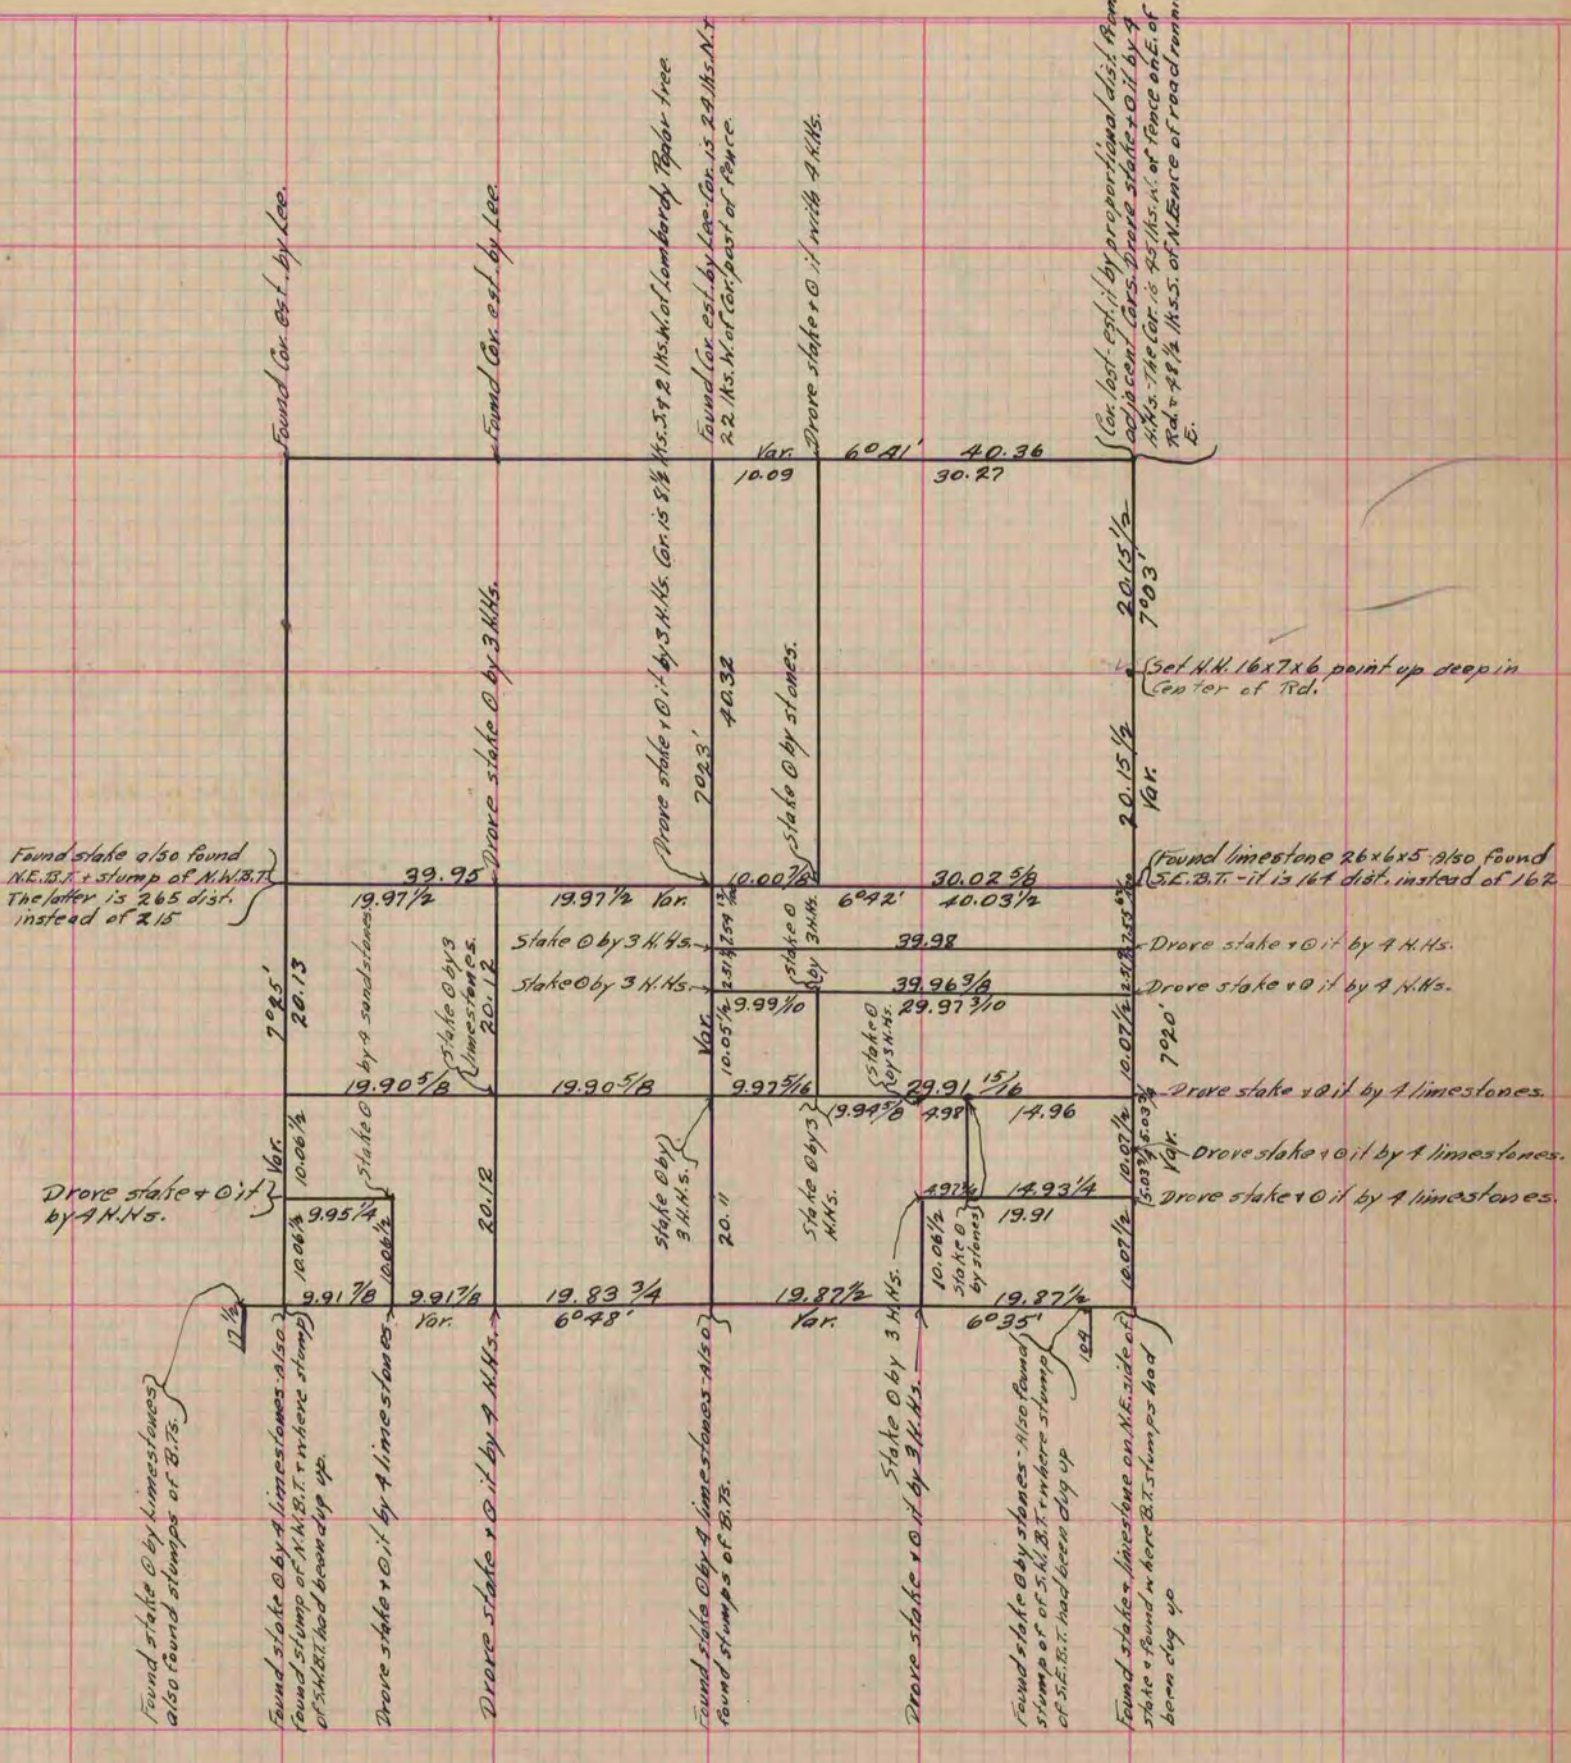

Copied from Page 91 Vol. 2. Original County Surveyors Record.