

# PLAT AND RECORD

233

Of a Survey on Section 23 T 3 R 13 E. of the 4 P. M. in Harmony Township


Rock County, Wisconsin, made November the 15, 16, 17 & 19 1877

I hereby certify that the following is a correct record of said survey as made by me.

COUNTY BUILDING  
IN CITY OF БЕЛОИТ

(Signed) *Edward Riser*  
*E. Riser*

County Surveyor.

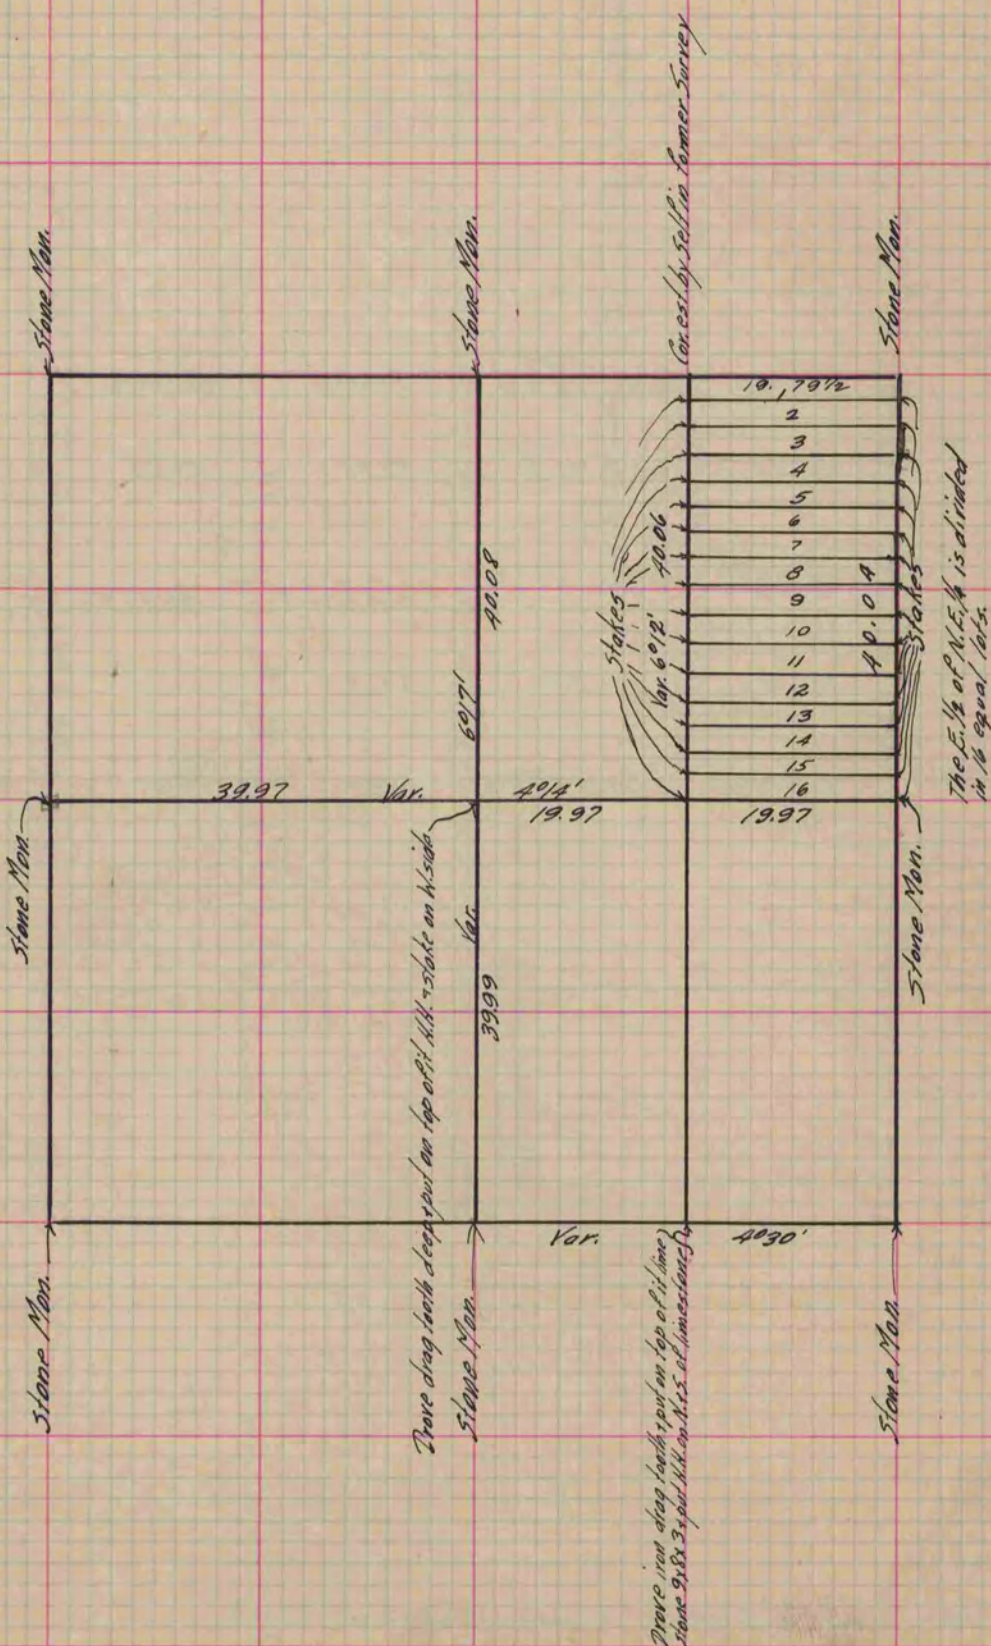

Copied From P. 187 Vol. 2 Original County Surveyor's Record.