Paper weight- 32# 25% Rag Ledger (minimum)


Black nonfading ink required

UBLIC MONUMENT RECORD

SURVEY

For Public Land Survey Corners in the $T. \perp N$, $R. \perp 13$

CORNER CODE INDEX

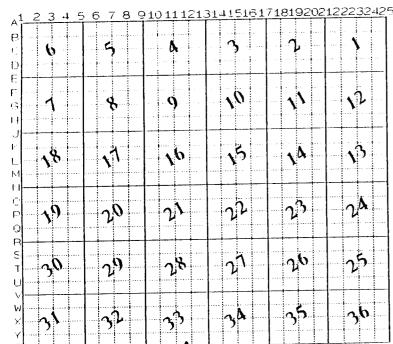

TURTLE TWP ROCK COUNTY WI

1F AVAILABLE ROCK COUNTY COORDITIATES PERFERRED

North 200,836,13 Elev.

East 5/0, 252.02

Hor. Datum COUNTY Vert. Datum

GPS (X) ____

TRAVERSE (X) X

BASED ON THE FOLLOWING CONTROL:

PLACE MONUMENT SYMBOL & LOCATION ON ABOVE INDEX AT PROPER

CORNER MONUMENT

O WITHESS MONUMENT

BEARINGS ARE BASED ON:

(a)

FIELD BOOK PAGE #

SHOW A PLAN VIEW DRAWLING DEPICTING THE COVER MONDERN AND SUPPRIORISING DRIVSTCAL FEATURES, INCLUDING THE EXCAVATION AREA AND DEPTH. THE CORRER MONDERN AND SUPPRIORISING DRIVSTCAL FEATURES, INCLUDING THE EXCAVATION AREA AND DEPTH. THE ORIGINAL POINT. THE FOLLOWING DHANGLERISTICS: IN HAVE A LEAST HAD PREDETERMINED BREAK-OFF POINTS. 21 IF BROKEN LEAVE A PERMANENTLY MAGNETIZED REMAINT AT THE ORIGINAL POINT. THE FOLLOWING DHANGLERIS: 51 OR AN EXISTING OUT LINESTORE. AN IRON IPPE 1 1/2"Y BINDS EXTENDED BY AN INFORMER OF THE SUPPRIANCE. IF THE CORNER IS SOCIEDED BY AN INFORMENT BINDSCRIPE CABLEBOOK AND AS INSTRUMENT BINDSCRIPE OF CONTROL OF THE SUPPRIANCE. IF THE CORNER IS SOCIEDED BY AN INFORMENT BINDSCRIPE CABLEBOOK AND DRABLE, DISTINCT MODULETING AN EXISTING USE AND CONTROLS SHALL BE REPERBURED WITH AT LEAST 4 DURBRIE WITHESS MONDREHIS SHALL BE MADE OF CONTROLS. HAILRIAL DURBRIE MODIFIES AND THE SOCIED BY AN INFORMENT BINDSCRIPE HAILRIAL DURBRIE WITHESS MONDREHIS SHALL BE MADE OF CONTROLS. SHEET / OF Z

FLAFFILMS & ZOULING COMMITTEE ADOPTED THE ABOVE FORM ON 12/2/1982 WI ADMINISTRATIVE CODE A-E 7.08 REQUIREMENT

SHEET _____
CORNER CODE

2 11/12

NW SEC 1 T46N R2E 4005 ILL511R2

- (B) Describe any record evidence, monument evidence, occupational evidence, testimonial evidence or any other material evidence you considered, and whether the monument was found or placed.
- 1838 SPALDING FIELD NOTES PG 394 & 395 INTERSECTED BASE LINE OF NW TERRITORY & NORTH BOUNDARY OF ILL 1828.20' WEST OF THE CORNER TO SEC 33 & 34 T1N R13E OF 4TH PM. AT SAID INTERSECTION SET A POST & STONE 16" LONG,10" WIDE,4" THICK FOR CORNER TO SEC 1 & 2 T46N R2E ORIGINAL PLAT CALLS FOR 1828.2
- 192? TISSANDIER MAP 5318.35 TO NE COR SEC 1, 5462.70 TO NW COR SEC 2, ANGLE 179-55-44 FROM NE COR SEC 1 TO NW COR SEC 2, LAT 42-30-16.55", & LONG 88-58-59.74".

FOUND BRASS PLUG IN CONCRETE MONUMENT. 5312.73 (REC 5318.35) TO NE COR SEC 1, 5465.13 (REC 5462.70) TO NW COR SEC 2, ANGLE 179-57-42 FROM NE COR SEC 1 TO NW COR SEC 2.

- C) Was the corner restored through acceptance of (1) an obliterated evidence location, or, (2) a found perpetuated location?
 ACCEPTED FOUND PERPETUATED LOCATION.
- D) Describe any material discrepancy between the location of the corner as restored or reestablished and the location of that corner as previously restored or reestablished by distance and direction. Show the discrepancy on the plan view drawing under (a), above. Show the distances between the corner as previously restored or reestablished and (1) the corner as restored or reestablished, and (2) to at least 4 of the witness monuments shown on the drawing in (a), above.
- (E) Was the corner reestablished through lost corner proportionate methods? If so, show the method, including the directions and distances to other public land survey corners used as evidence or used for proportioning the corner location.

I, Donald Barnes, hereby certify that the corner points as identified by the corner code index were, in a field survey on,1994, established, re-established, monumented, re-monumented, recovered or restored as expressed below and in conformance with the regulations and rules as required in the current manual of survey instructions of the United States Department of Interior, Bureau of Land Management.

COUNTY SURVEYOR FILING DATA

Date of computer entry___

Date microfilmed _____

Number of included sheets _____ CORNER CODE

EMBOSS LAND SURVEYOR SEAL

seal

21//2

ILLINOIS ORIGINAL GOVERNMENT FIELD NOTES T46N R2&3E CERTIFICATE DEC 29,1836

D.A. SPAULDING WILLIAM TOP

HENRY CHANDLER

DL

JAMES THOMAS
R. WALLER

The state of the s

CH CHAINMAN CHAINMAN FLAGMAN

AXE MAN

ALL CORNER POSTS WERE INSERTED 2' INTO A HOLE DUG IN THE GROUND WITH AN AXE & SPADE THROUGH THE FROST & THEY WERE SECURELY RAMMED IN WITH EARTH. THE STONES USED FOR CORNERS WERE OBTAINED AT DIFFERENT QUARRIES IN THE ?? AND WERE SET 1 1/2 THEIR LENGTH IN THE GROUND & ON ALL THE N/S LINES, THEY WERE SET THE WEST SIDE OF THE POSTS & EDGES FACING N/S AND ON THE E/W LINES THEY WERE SET THE NORTH SIDE OF THE POSTS & EDGES FACING E & W.

THE SAID POSTS WERE OF THE MOST DURABLE WOOD THAT COULD BE HAD IN THE LAND GENERALLY BURR OAK. THE SECTION POSTS WERE 5' LONG & WERE NOT LESS THAN 5" IN DIA., THAT THEY WERE NEATLY SQUARED AT TOP & THEN PLACED WITH THE CORNERS TO THE CARDINAL POINTS. (CONTINUES WITH OTHER STATEMENTS).

PAGE 857. DEC 26, 1838 MEASURED CHAIN COMPARED WITH THE STANDARD CHAIN & LIST IT TO BE A HALF INCH TOO LONG. MAKE IT OF THE PROPER LENGTH.