

PLAT AND RECORD

Of a Survey on Section 5 T 4N R 14 E. of the 4 P. M. in LIMA Township

Rock County, Wisconsin, made AUGUST the 15 1967


I hereby certify that the following is a correct record of said survey as made by me.

COUNTY BUILDING
IN CITY OF BELOIT

R. B. Atkinson

County Surveyor. **N**


THE GEO. S. BARNARD COMPANY, ST. LOUIS

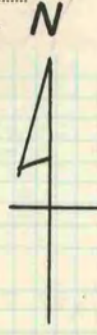

S 1/4 COR SEC 5 LIMA TWP
FOUND CAPPED PIPE SET BY B.J. SUNNY
Fd MON BOX OVER 1" I. PIPE
8/20/71 (JMS)
G.B.
JEL.

C. T. H.

"N"

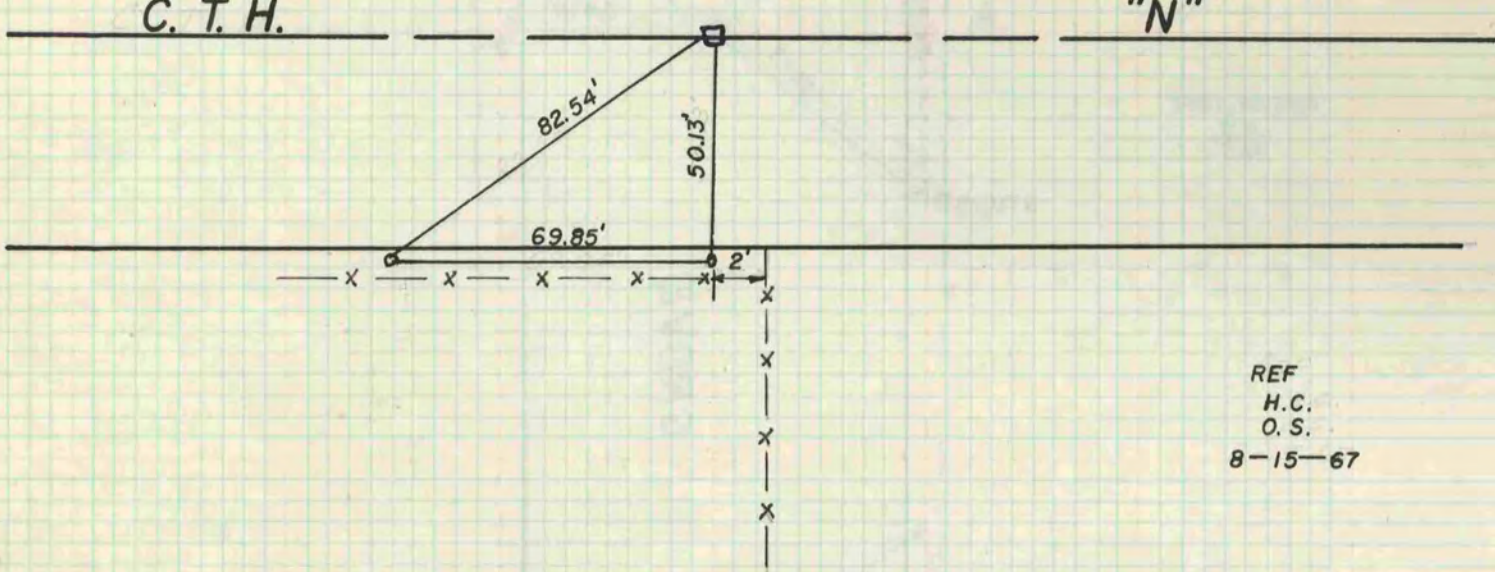

REF
H.C.
O.S.
8-15-67