

PLAT AND RECORD

Of a Survey on Section 23 T 4 R 10 E. of the 4 P. M. in Union Township


Rock County, Wisconsin, made October the 20, 21 & 22 1875

I hereby certify that the following is a correct record of said survey as made by me.

COUNTY BUILDING
IN CITY OF БЕЛОИТ

(Signed) Edward Roger
CRB

County Surveyor.

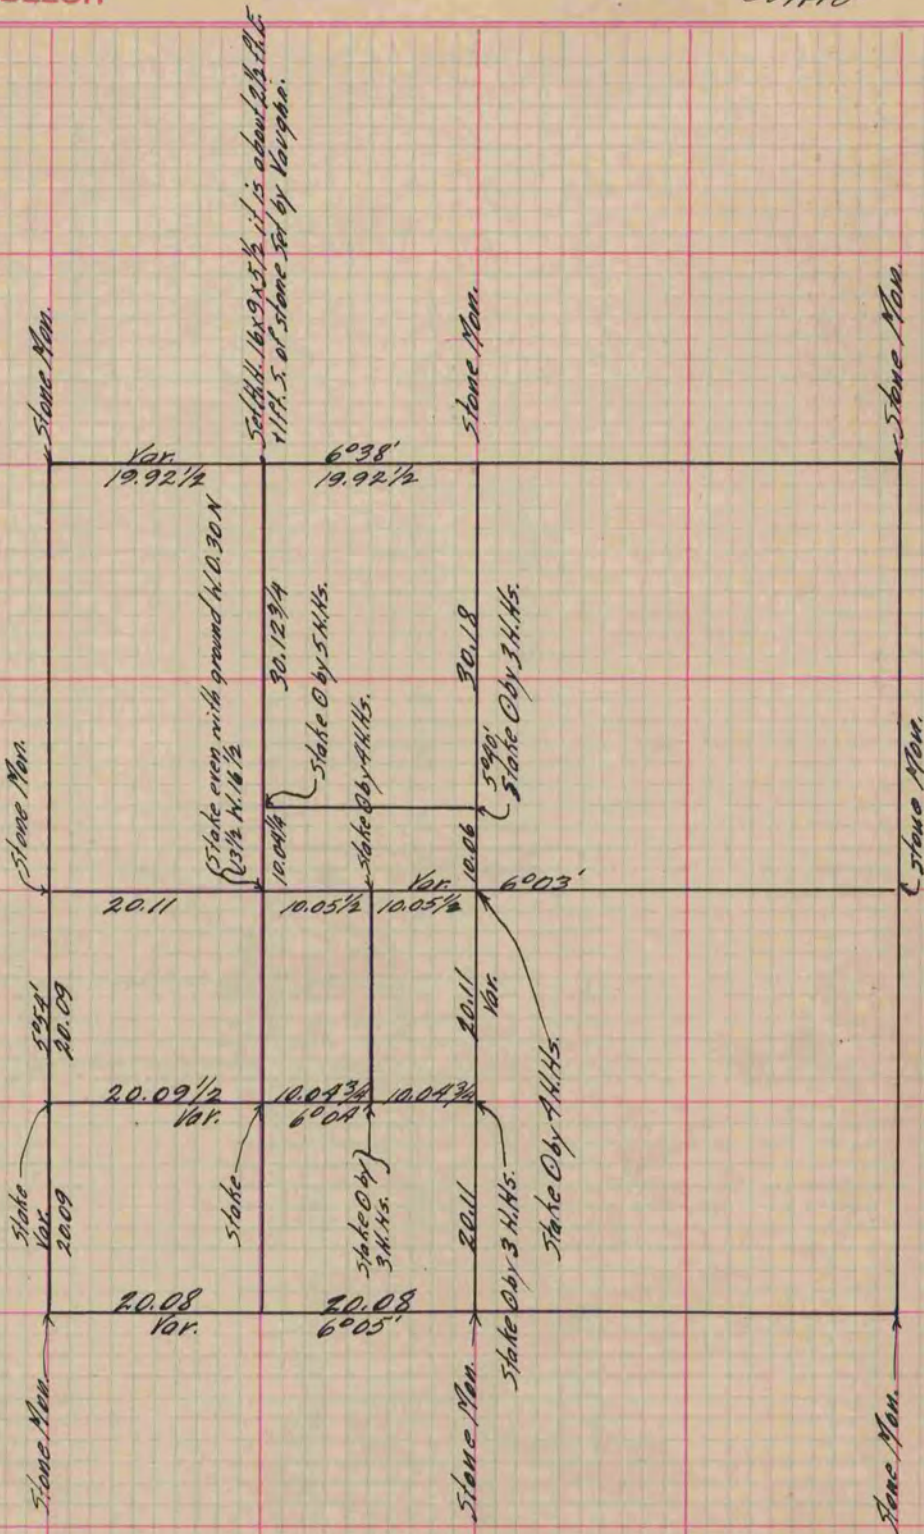

Copied from P. 155 Vol. 2 Original County Surveyor's Record.