

PLAT AND RECORD

Of a Survey on Section 9 T 3 R 13 E. of the 4 P. M. in Harmony Township


Rock County, Wisconsin, made January the 20 121 1876

I hereby certify that the following is a correct record of said survey as made by me.

COUNTY BUILDING
IN CITY OF БЕЛОIT

(Signed) —

County Surveyor.

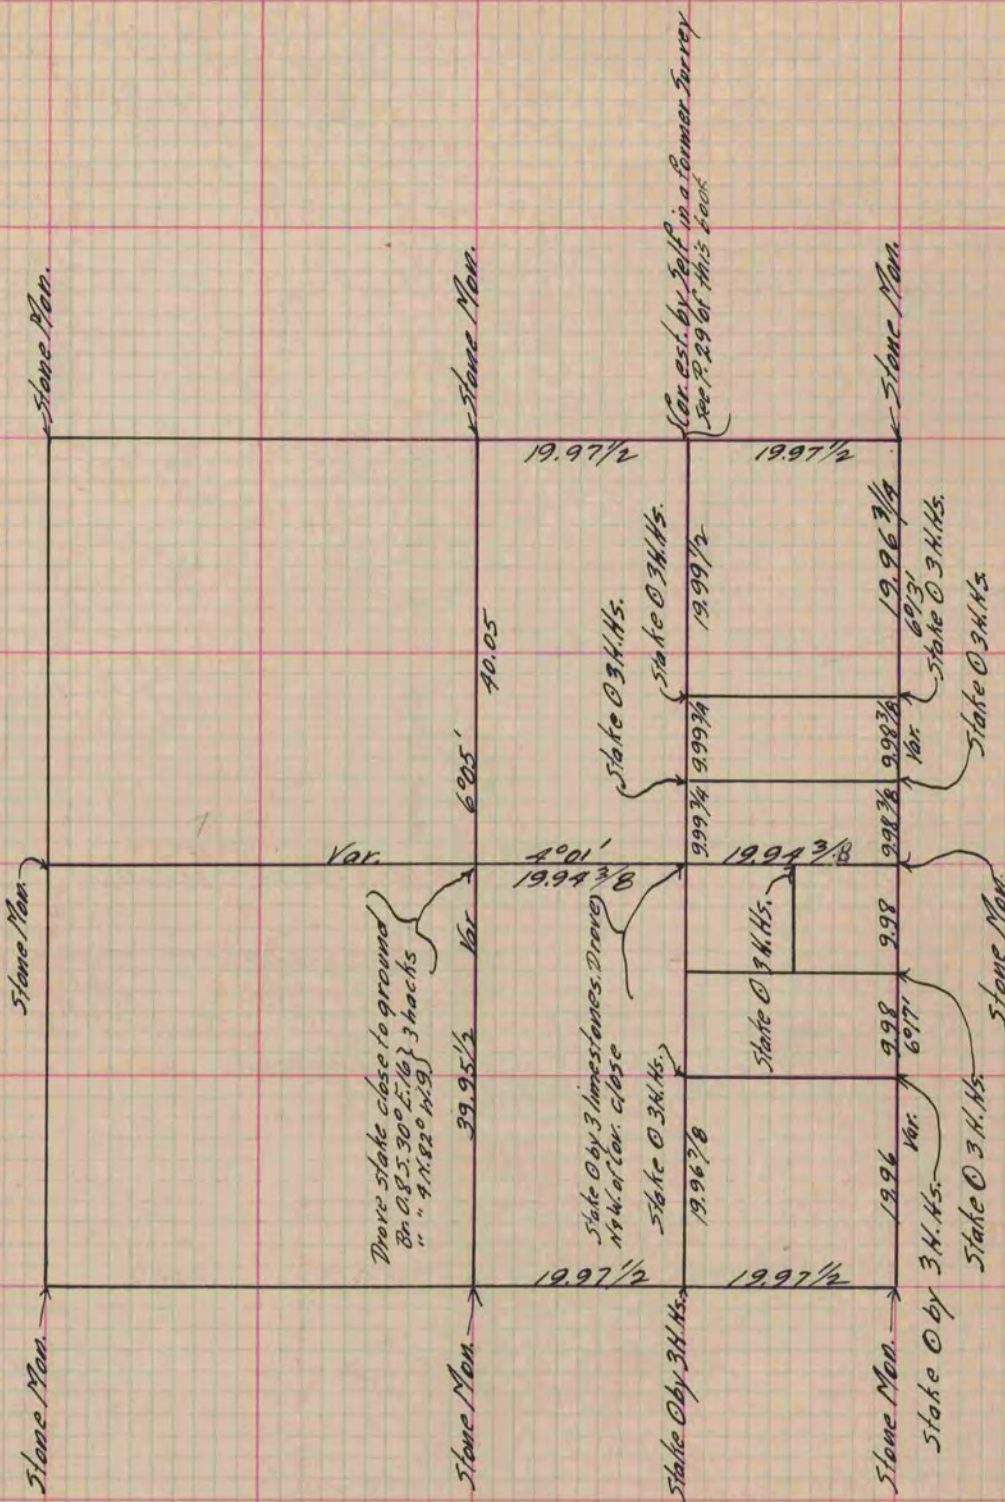

Copied from P. 157 Vol. 2 Original County Surveyor's Record.