

# PLAT AND RECORD

Of a Survey on Section 26 T 2 R 14 E. of the 4 P. M. in Bradford Township


Rock County, Wisconsin, made June the 5th 1877

I hereby certify that the following is a correct record of said survey as made by me.

COUNTY BUILDING  
IN CITY OF БЕЛОIT

(Signed) Edward Roger  
R. R. B.

County Surveyor.

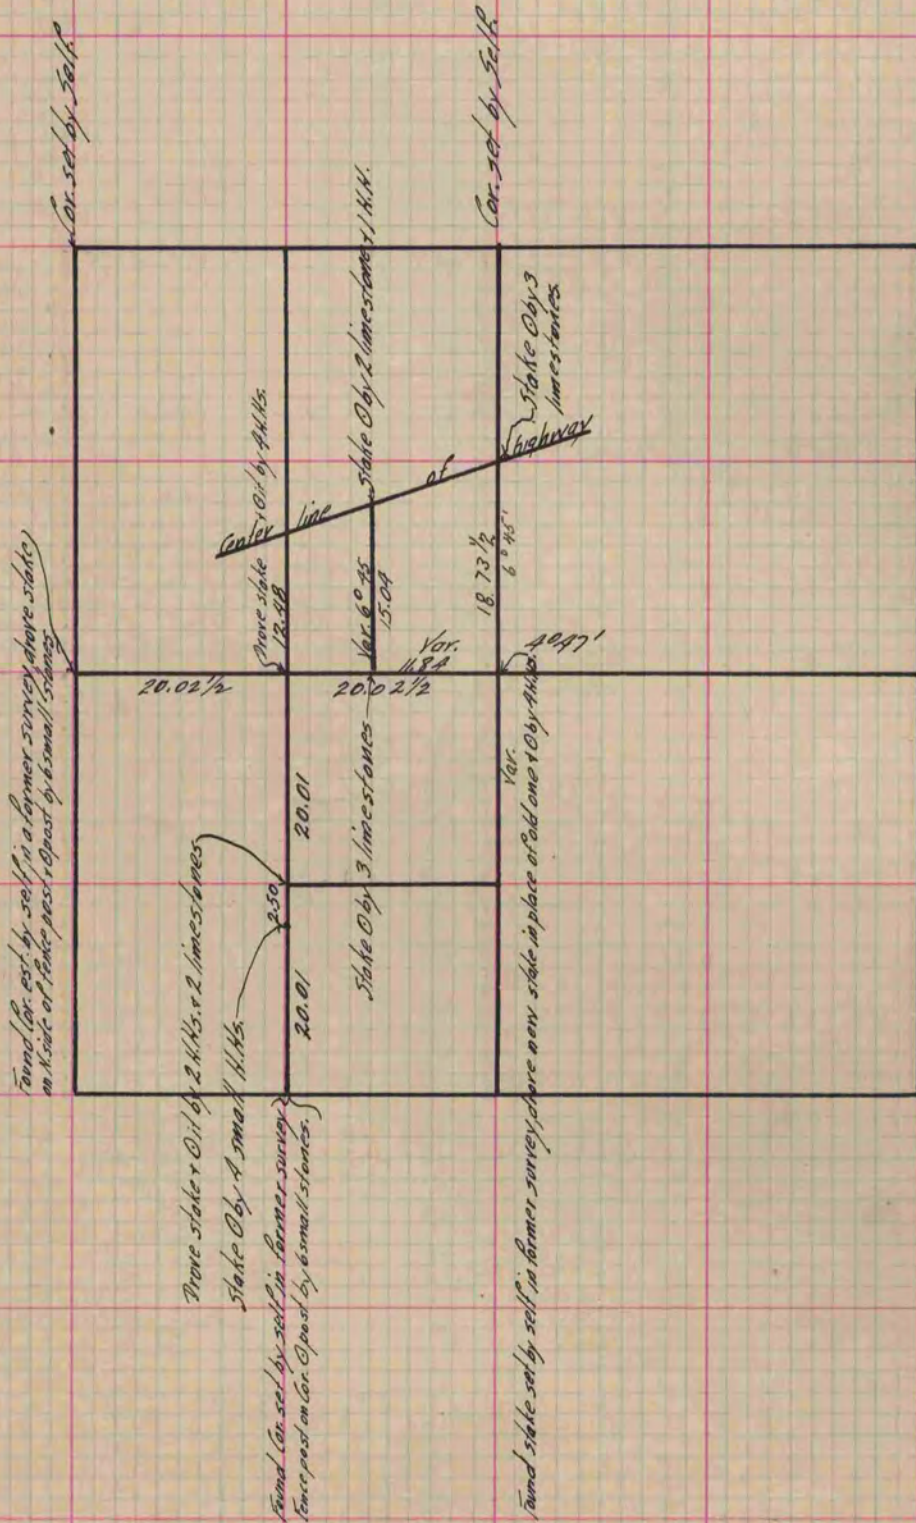

Copied from P. 184 Vol. 2 Original County Surveyor's Record.