

PLAT AND RECORD


Of a Survey on Section 4 T 2 R 11 E. of the 4 P. M. in Plymouth Township
Rock County, Wisconsin, made March the 31st 1865

I hereby certify that the following is a correct record of said survey as made by me.

COUNTY BUILDING
IN CITY OF BELOIT

(Signed) S. D. Locke
RMB County Surveyor.

Found old stake, set poplar stake with limestone
20x12x8 on N. & lime 20x6x4 on S. & smaller one
on West in mound.

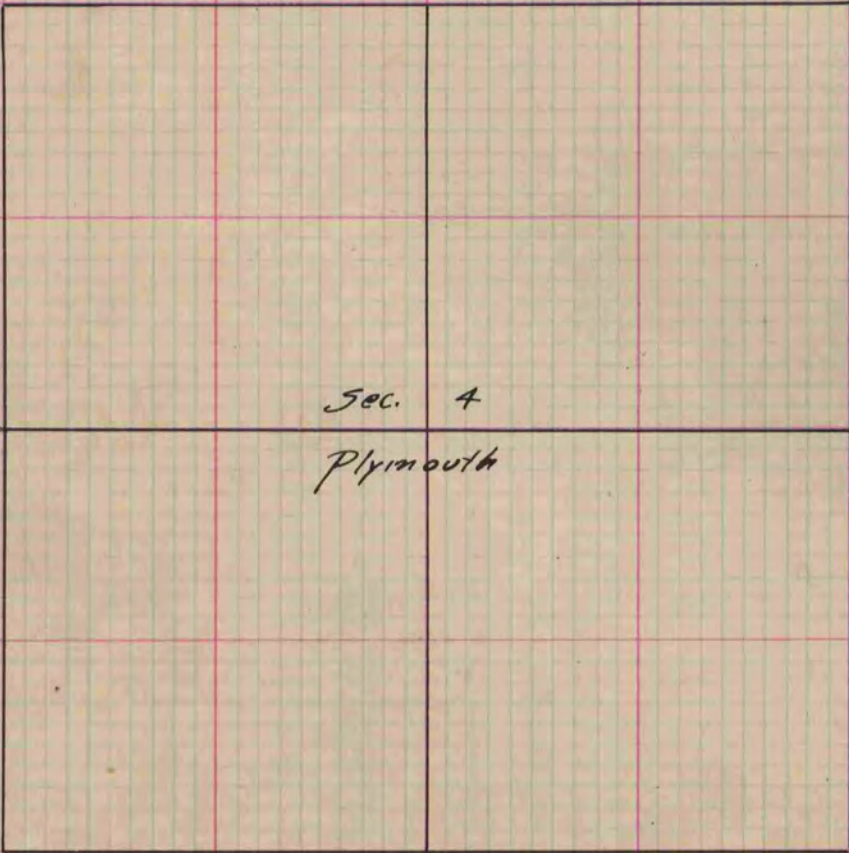

Copied from page 216 Vol. 1. Original County Surveyor's Record.