

PLAT AND RECORD


Of a Survey on Section 5 T 4 R 11 E. of the 4 P. M. in Porter Township
Rock County, Wisconsin, made June the 6th 1873

I hereby certify that the following is a correct record of said survey as made by me.

COUNTY BUILDING
IN CITY OF BELOIT

(Signed) R. K. Lee
A.M.S.

Deputy
County Surveyor.

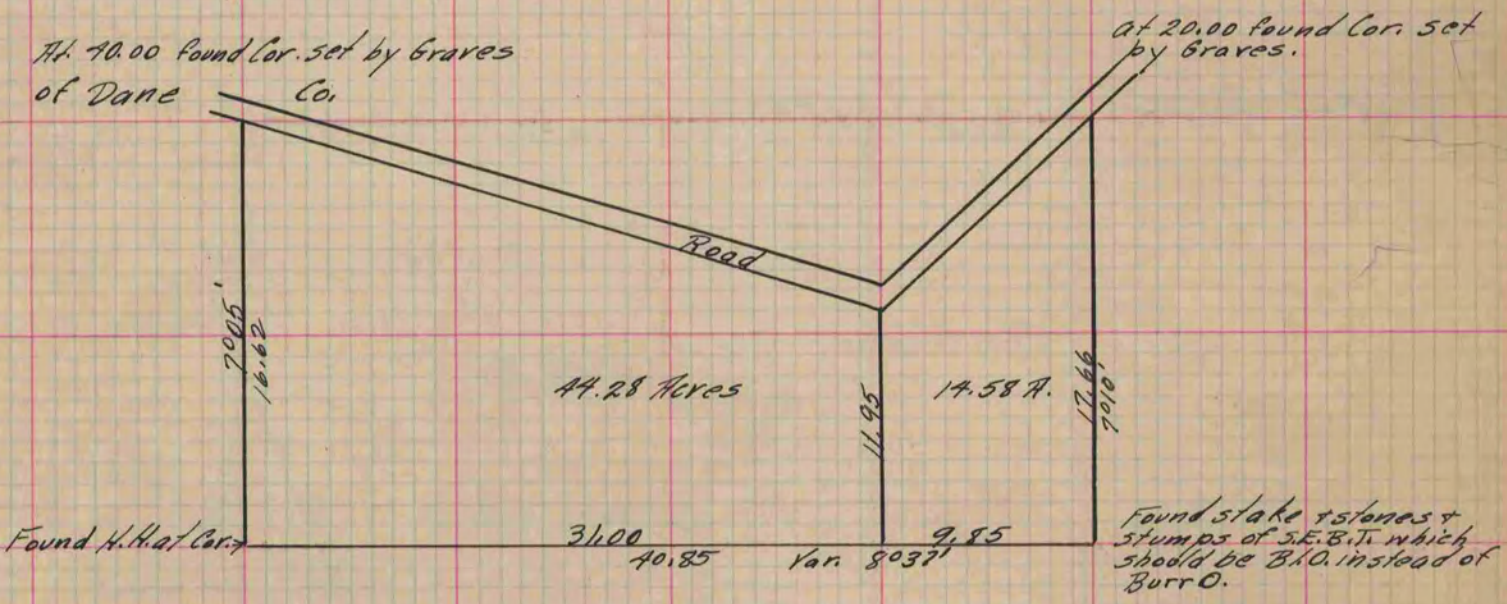

Copied from Page 62 Vol. 2 Original County Surveyor's Records