

PLAT AND RECORD


Of a Survey on Section 15 T 2 N. R 12 E. of the 4 P. M. in ROCK Township

Rock County, Wisconsin, made OCTOBER the 27 1971

I hereby certify that the following is a correct record of said survey as made by me.

Hugh J. Bee
County Surveyor.

COUNTY BUILDING
IN CITY OF BELOIT

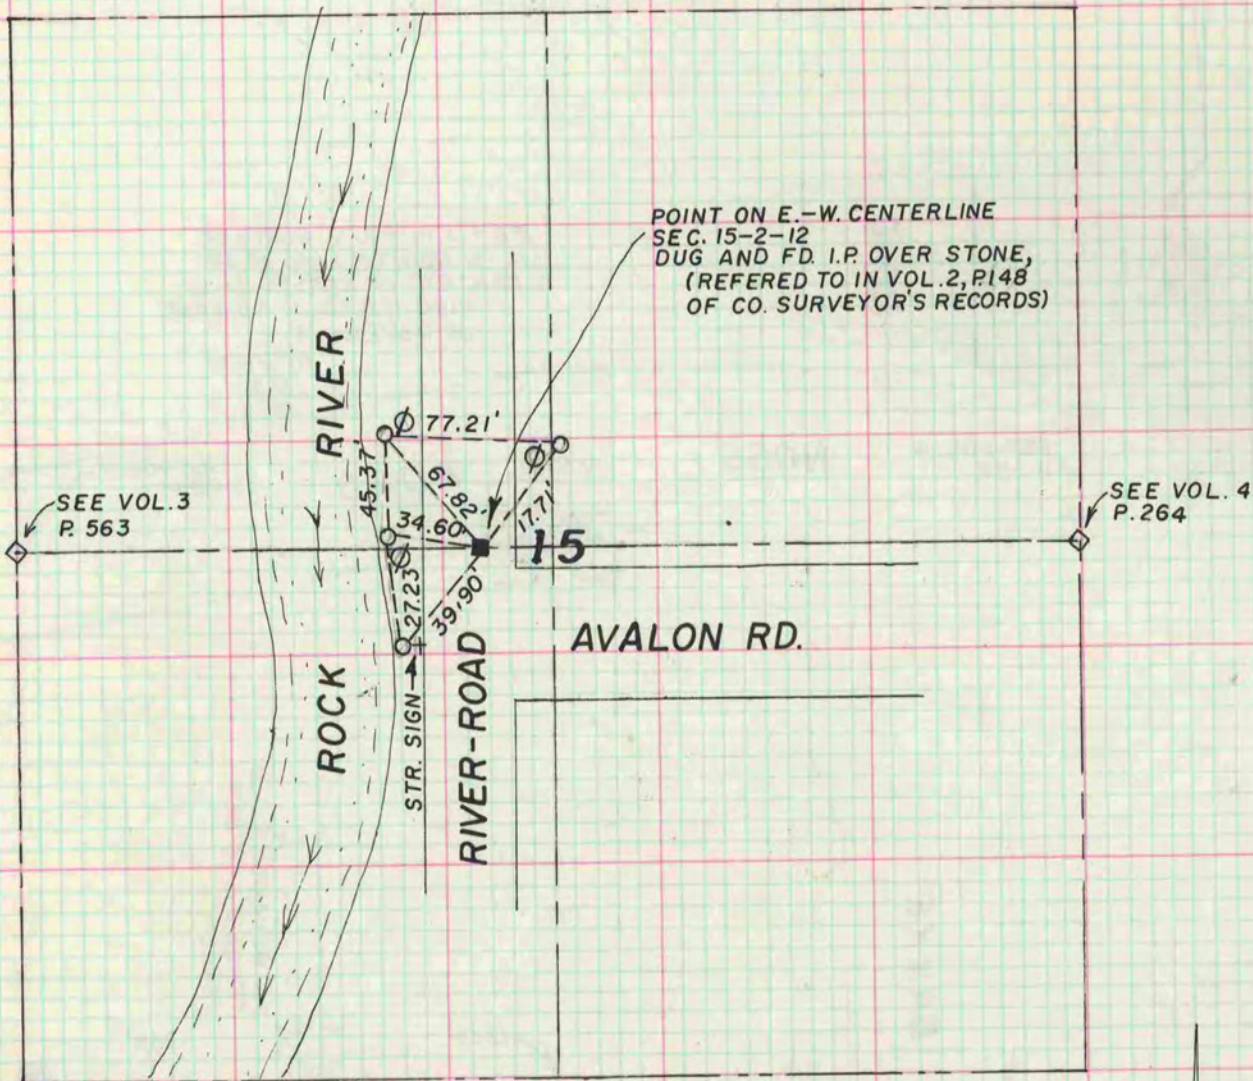

NOTE: O = 1" x 24" IRON PIPE REF.

BK. 152 A, P. 62
10/27/71
J.M.S.
B. K.

