


PLAT AND RECORD

Of a Survey on Section 28 T 3 R 10 E. of the 4 P. M. in Magnolia Township
Rock County, Wisconsin, made July the 8th + 9th 1869

I hereby certify that the following is a correct record of said survey as made by me.

COUNTY BUILDING
IN CITY OF BELOIT

(Signed) R. K. Lee
Dep. County Surveyor.

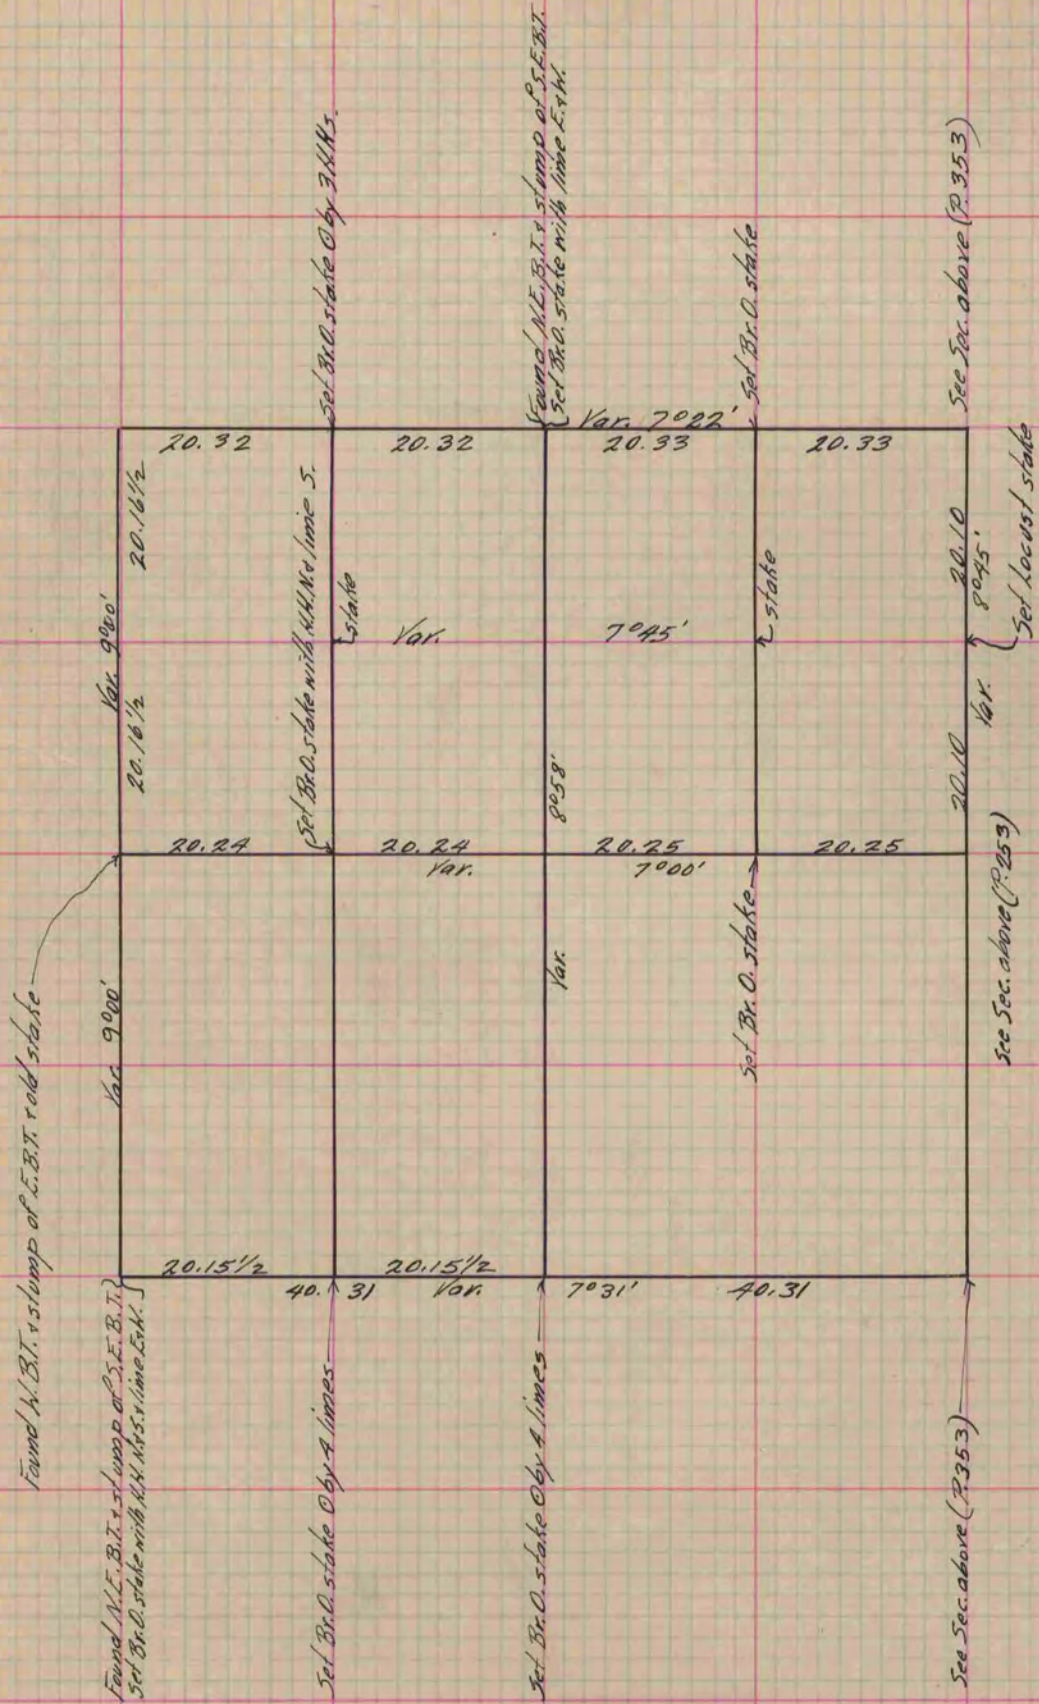

Copied from P. 284 Vol. 1 County Surveyor's Record.