

PLAT AND RECORD

Of a Survey on Section 33 T 3 R 12 E. of the 4 P. M. in JAMESVILLE Township
 Rock County, Wisconsin, made FEB the 1970


I hereby certify that the following is a correct record of said survey as made by me.

**COUNTY BUILDING
 IN CITY OF BELOIT**

R. B. Atkinson Jr

County Surveyor.

THE GEO. D. BARNARD COMPANY, ST. LOUIS

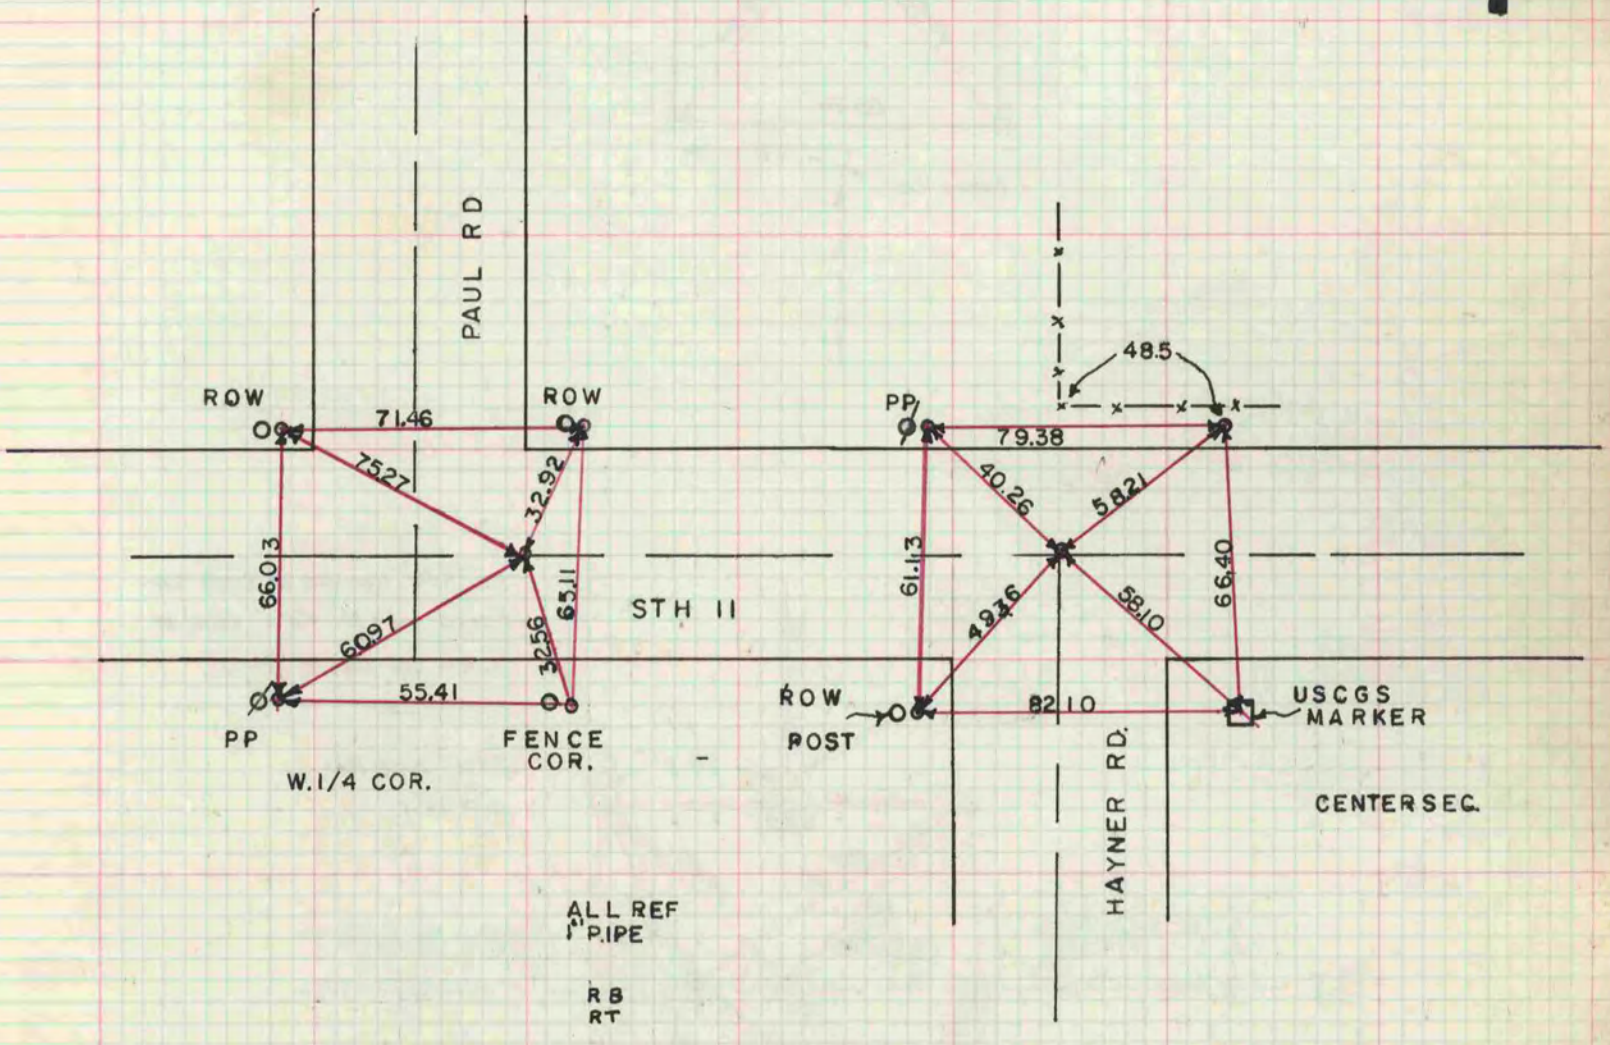

ALL REF
 1" PIPE

RB
 RT