

Of a Survey on Section .25 T 4 R 13 E. of the 4 P. M. in MILTON Township


Rock County, Wisconsin, made MAY the 29th 1973

I hereby certify that the following is a correct record of said survey as made by me.

COUNTY BUILDING
IN CITY OF BELOIT

M.L.G.B. J.L.
County Surveyor

THE GEO. D. BARKARD COMPANY, ST. LOUIS

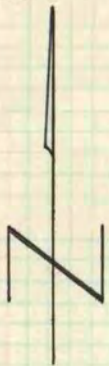

AT N.E. COR. SEC. 25 FD. 1" PIPE
SURROUNDED BY 3 H.H. AND I L.S.

3-22-73 W.K. M.L.

REF AND SET C.I. MON. 5-29-73

M.L.G.B. J.L.

