

PLAT AND RECORD


509
OK

Of a Survey on Section 8 T3 N R 14 E. of the 4 P. M. in JOHNSTOWN Township
Rock County, Wisconsin, made MAY the 20 1971

I hereby certify that the following is a correct record of said survey as made by me.

Hugh J. Lee
County Surveyor.

COUNTY BUILDING
IN CITY OF BELOIT

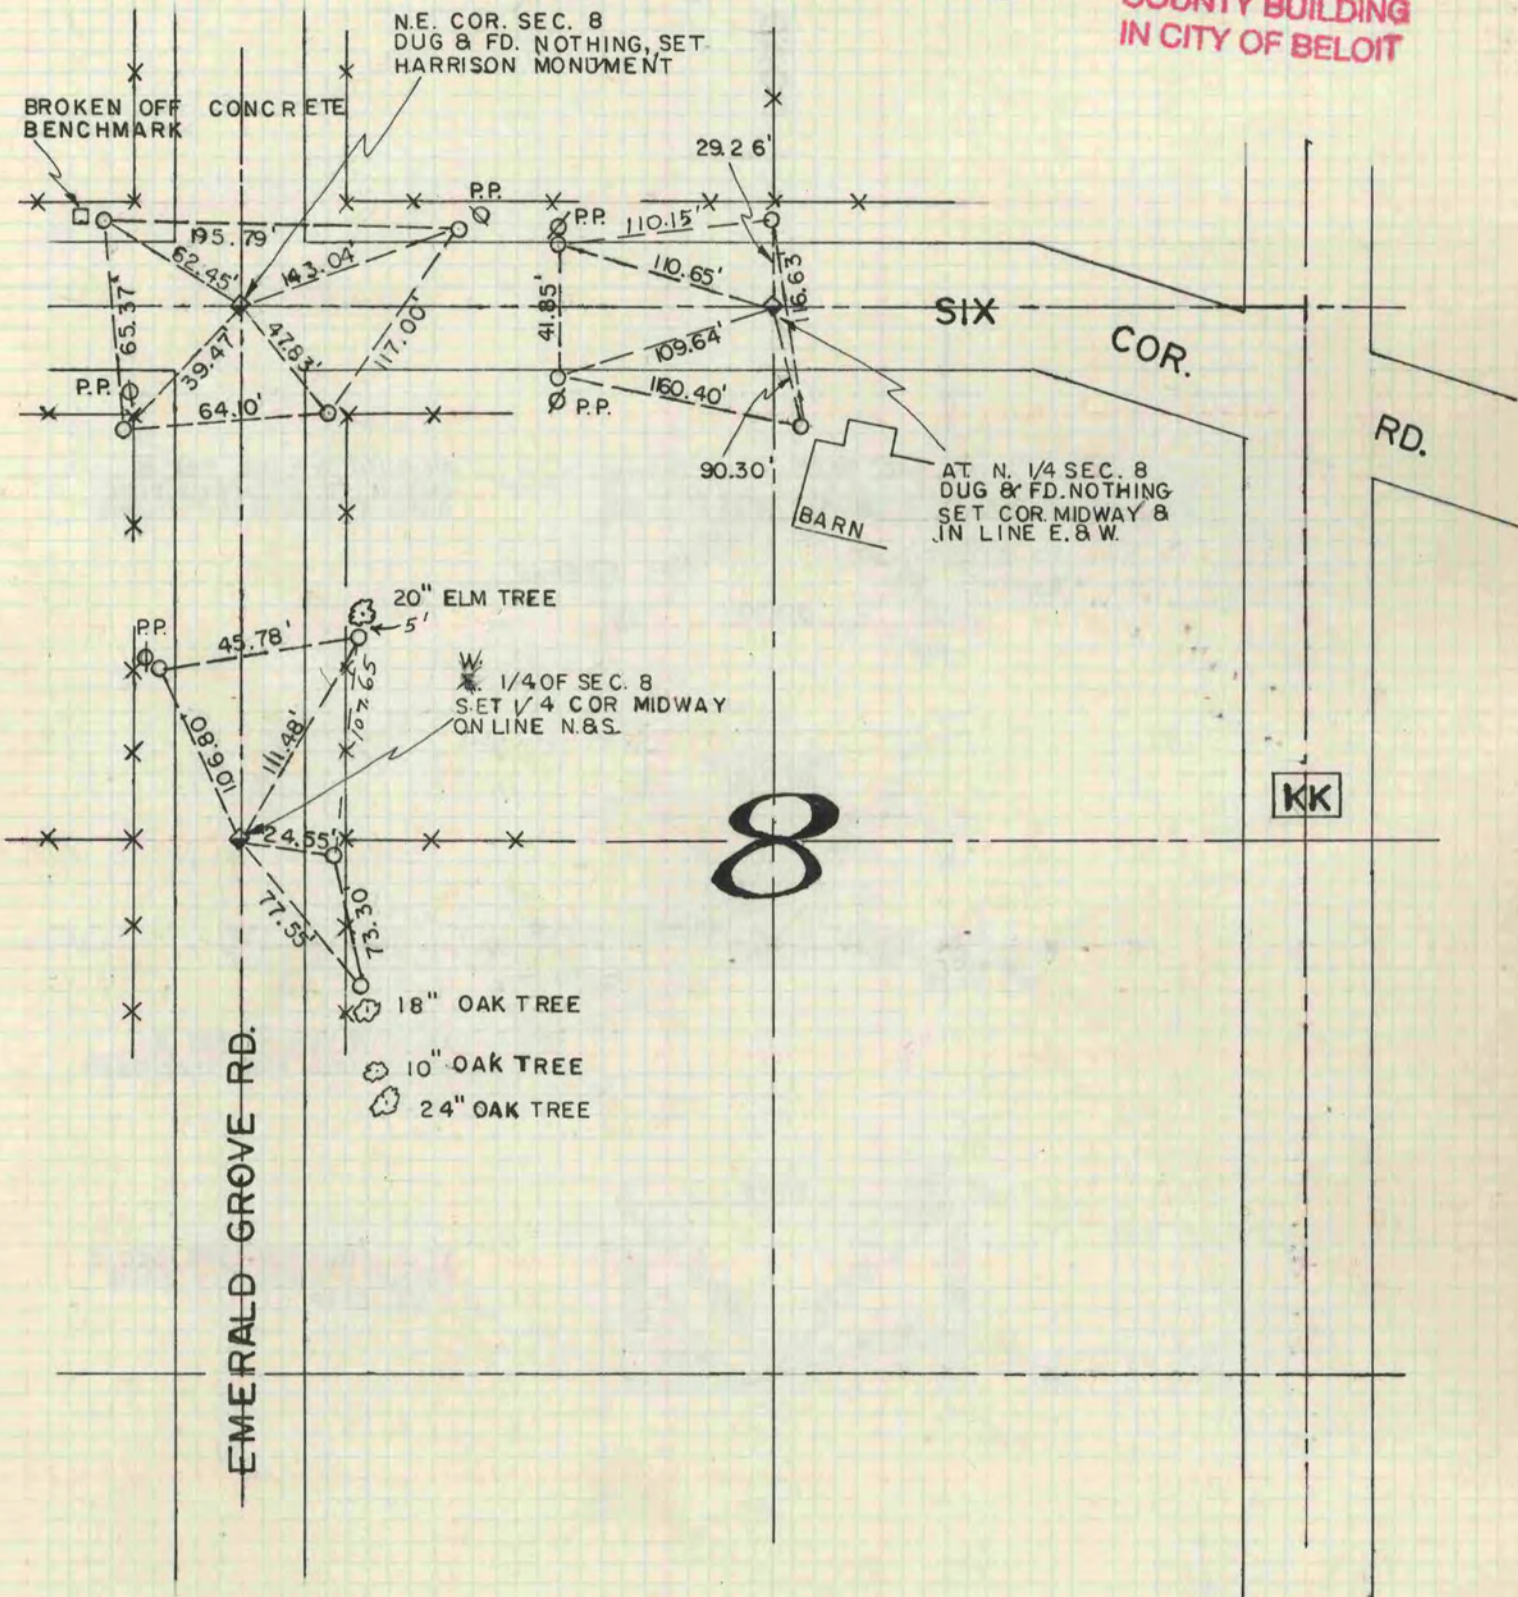

NOTE: O = 1" x 24"
IRON PIPE R E F. MON.
JMS
JEL

