

PLAT AND RECORD

515


Of a Survey on Section 33 T 4N R 11 E. of the 4 P. M. in PORTER Township

Rock County, Wisconsin, made July the 18th 1957

I hereby certify that the following is a correct record of said survey as made by me.

COUNTY BUILDING
IN CITY OF BELOIT

County Surveyor.

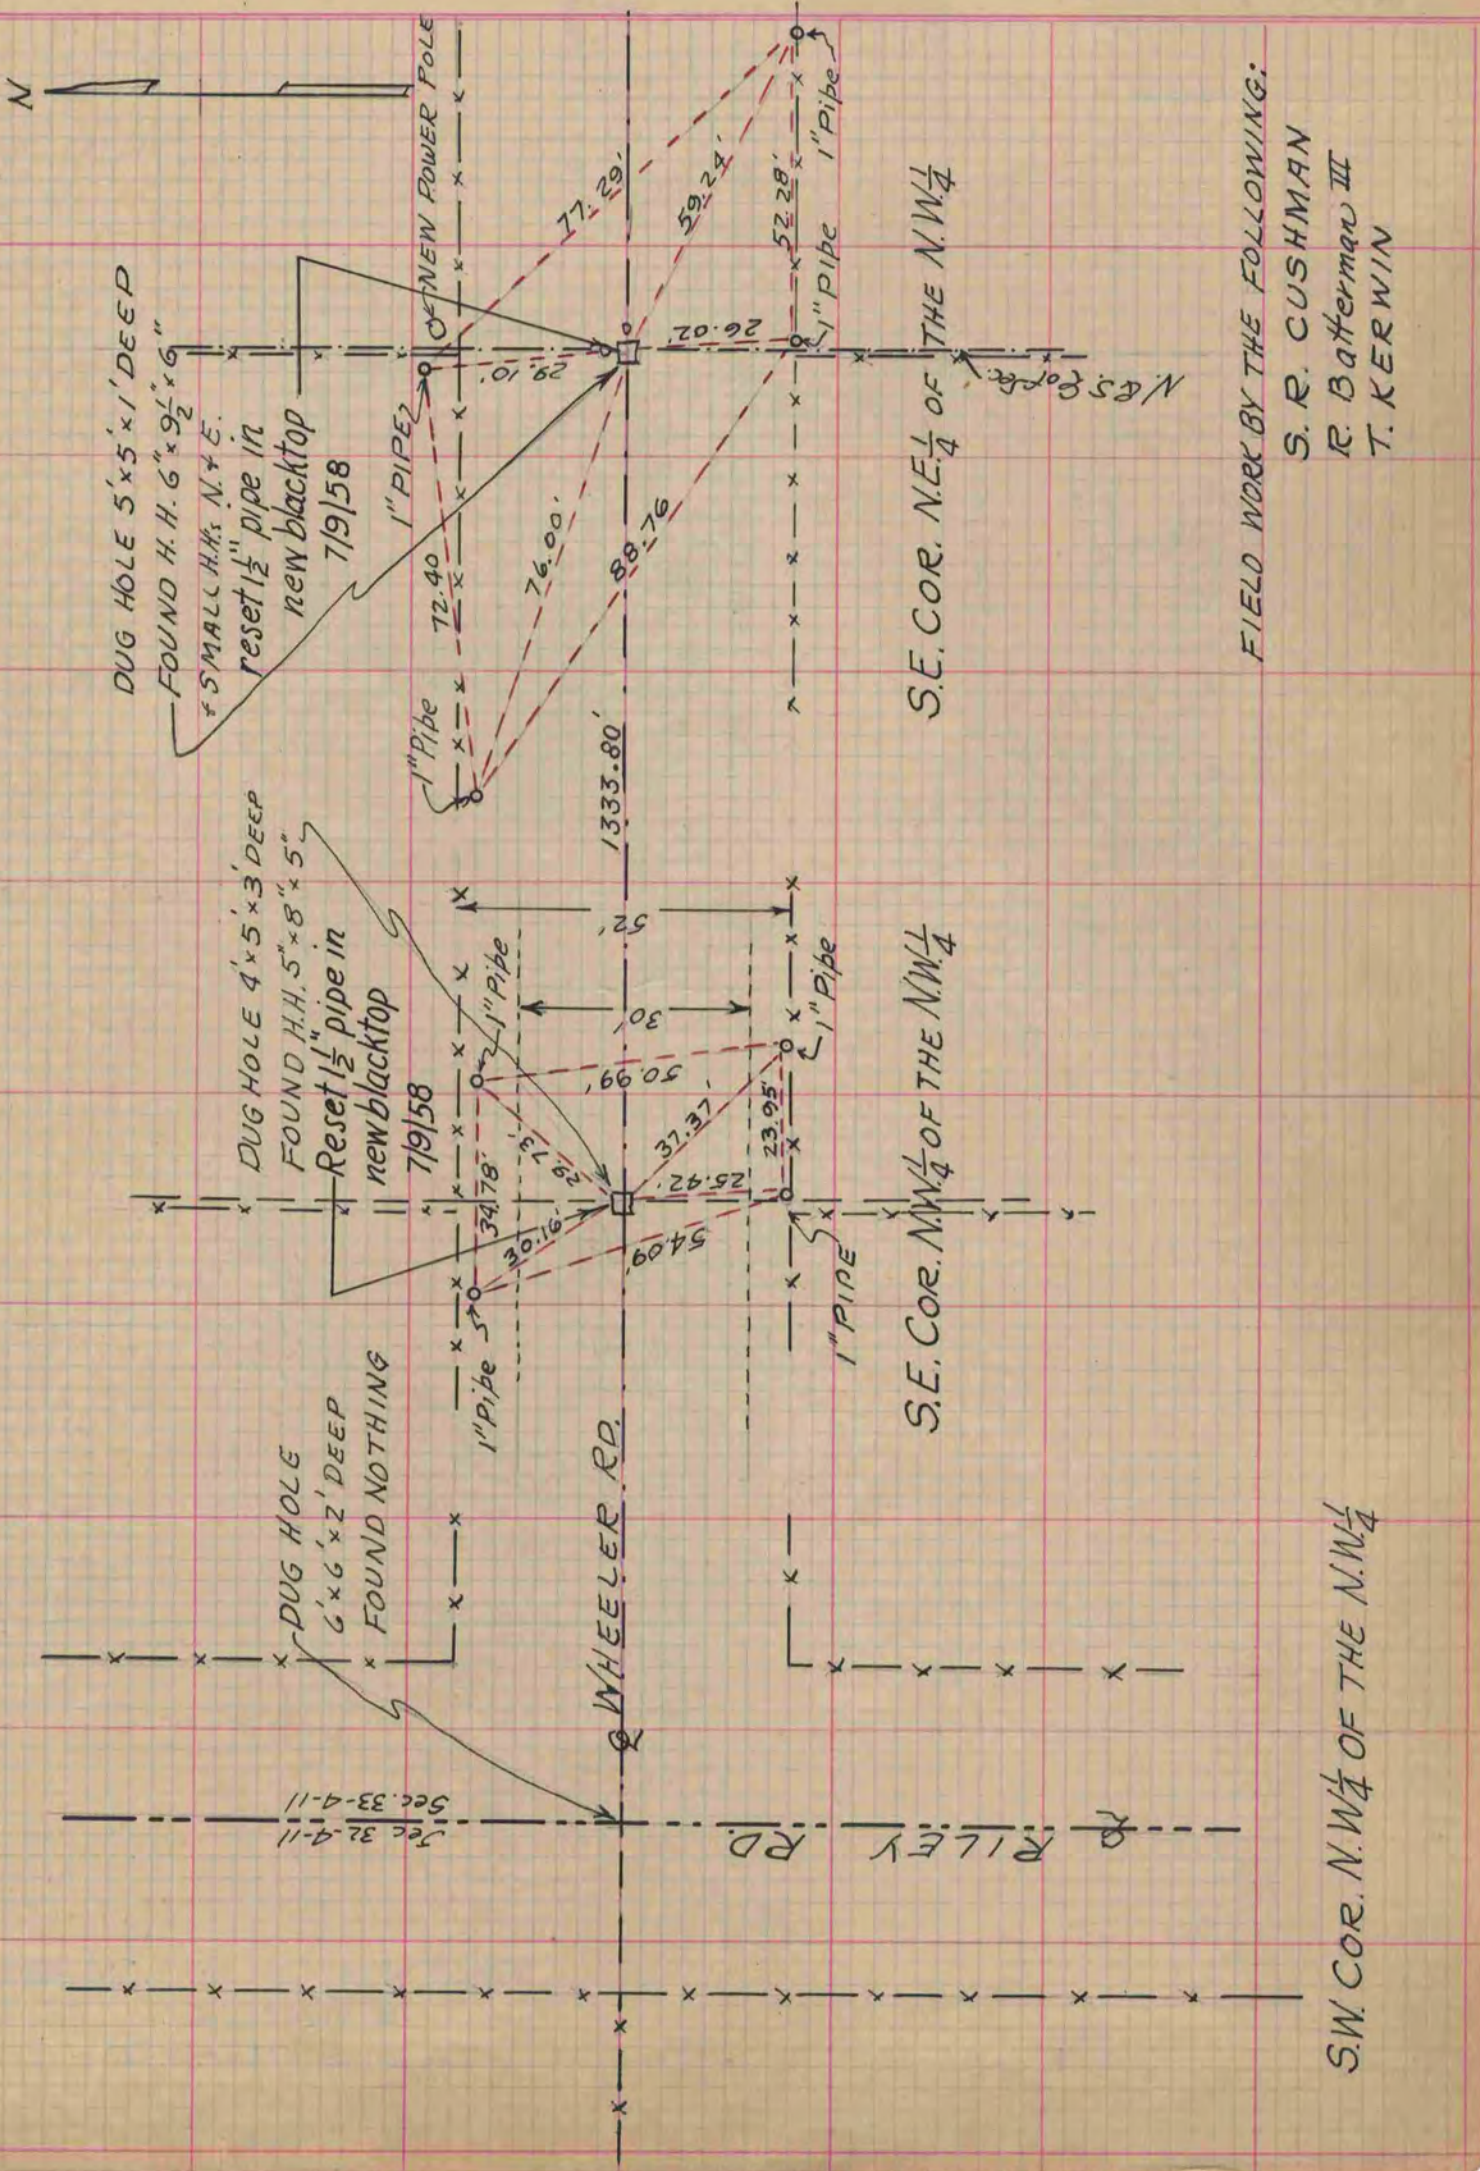

FIELD WORK BY THE FOLLOWING:
S. R. CUSHMAN
R. Batterman III
T. KERWIN

S.W. COR. N.W. 1/4 OF THE N.W. 1/4