

PLAT AND RECORD

Of a Survey on Section 12 T 1 R 12 E. of the 4 P. M. in Beloit Township

Rock County, Wisconsin, made May the 7th 1882

COUNTY BUILDING
IN CITY OF BELOIT

I hereby certify that the following is a correct record of said survey as made by me.


(Signed) S. F. Holmes
R. F. L. County Surveyor.

Found limestone set in ground in the
highway said by Thos. Henderson &
Clark to have been placed where the
post stood in the spring of 1863.

Sec. 12 Beloit

N 40° W or Yrs of 40
39.93
Set several stakes on a right
line.

Limestone said by T. Hender-
son to be set where the Genl. stake
stood in the spring of 1863, & said
marked stake stood beside stone
for several years.

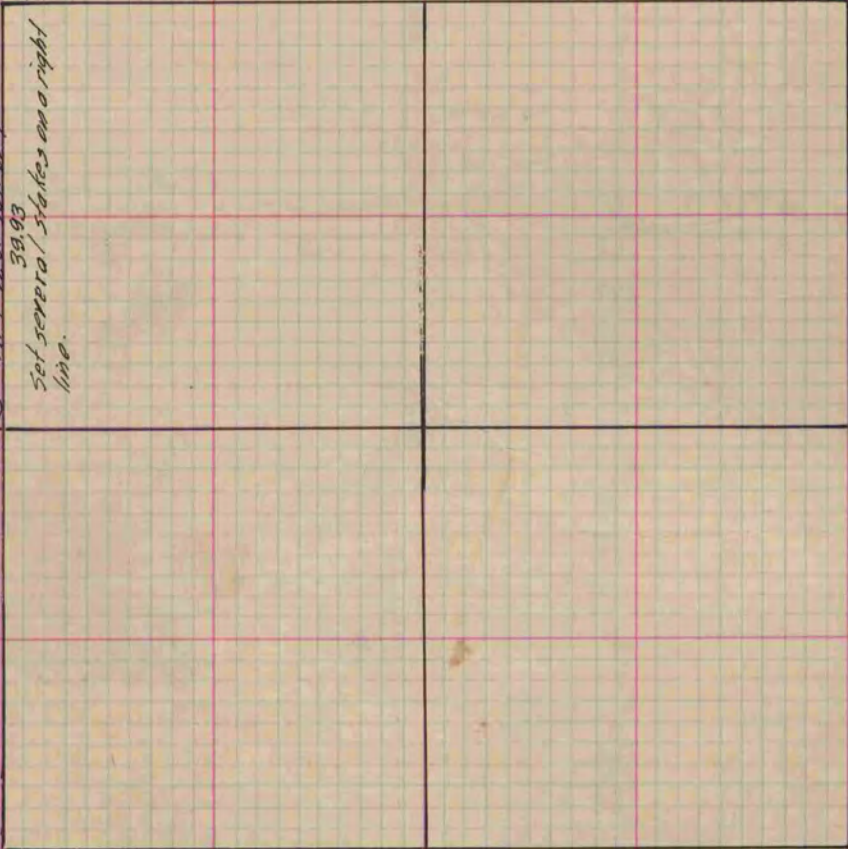

Copied from P. 284 Vol. 2 County Surveyor's Record.