


PLAT AND RECORD

Of a Survey on Section ^{25, 26} 35, 36 T 3 R 10 E. of the 4 P. M. in MAGNOLIA Township
Rock County, Wisconsin, made the 29th of March to the 2nd of April 1957

I hereby certify that the following is a correct record of said survey as made by me.

COUNTY BUILDING
IN CITY OF BELOIT

Richard H. Battersman, Jr.
County Surveyor.

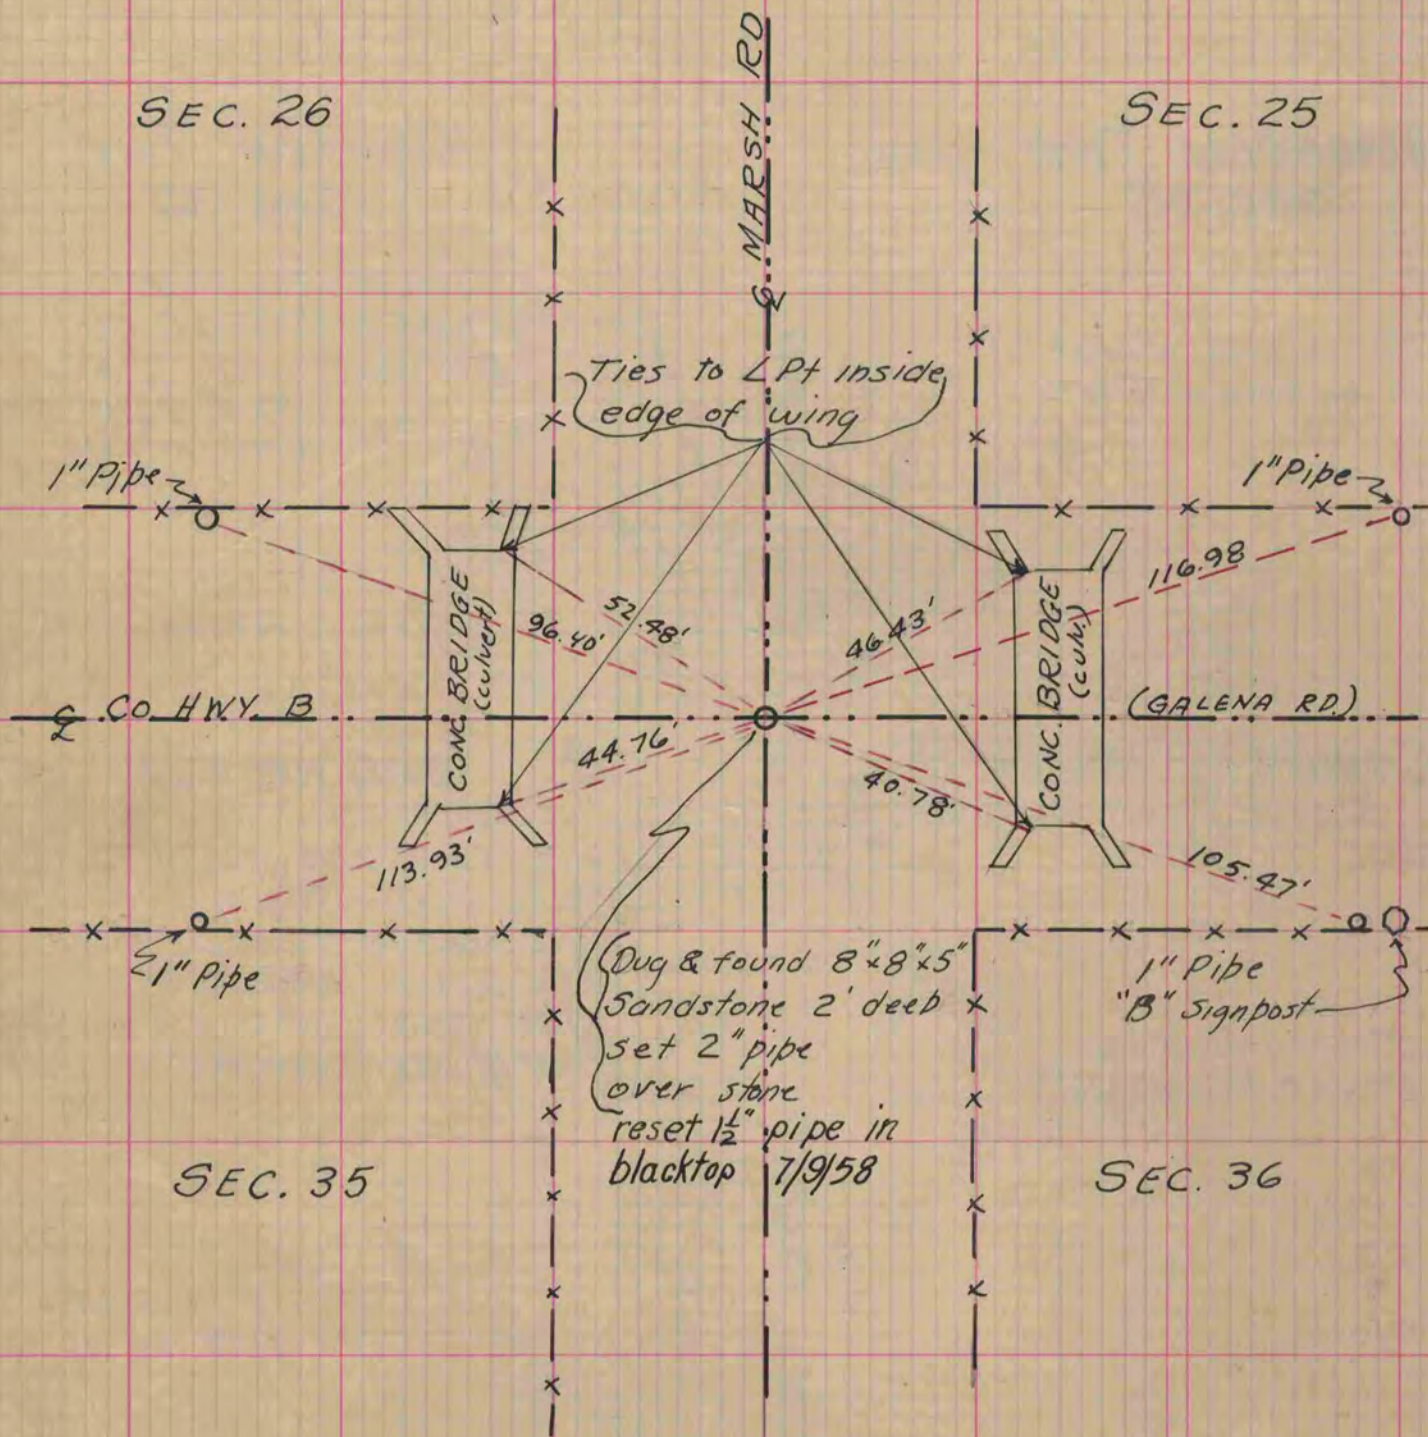

Field Work by the following:
J. R. Dull
S. R. Cushman
Tom Walsh