

PLAT AND RECORD


Of a Survey on Section 35 T 3 R 13 E. of the 4 P. M. in Harmony Township

Rock County, Wisconsin, made May the 18 1874

I hereby certify that the following is a correct record of said survey as made by me.

COUNTY BUILDING
IN CITY OF BELOIT

(Signed) Edward Ruger.
County Surveyor.

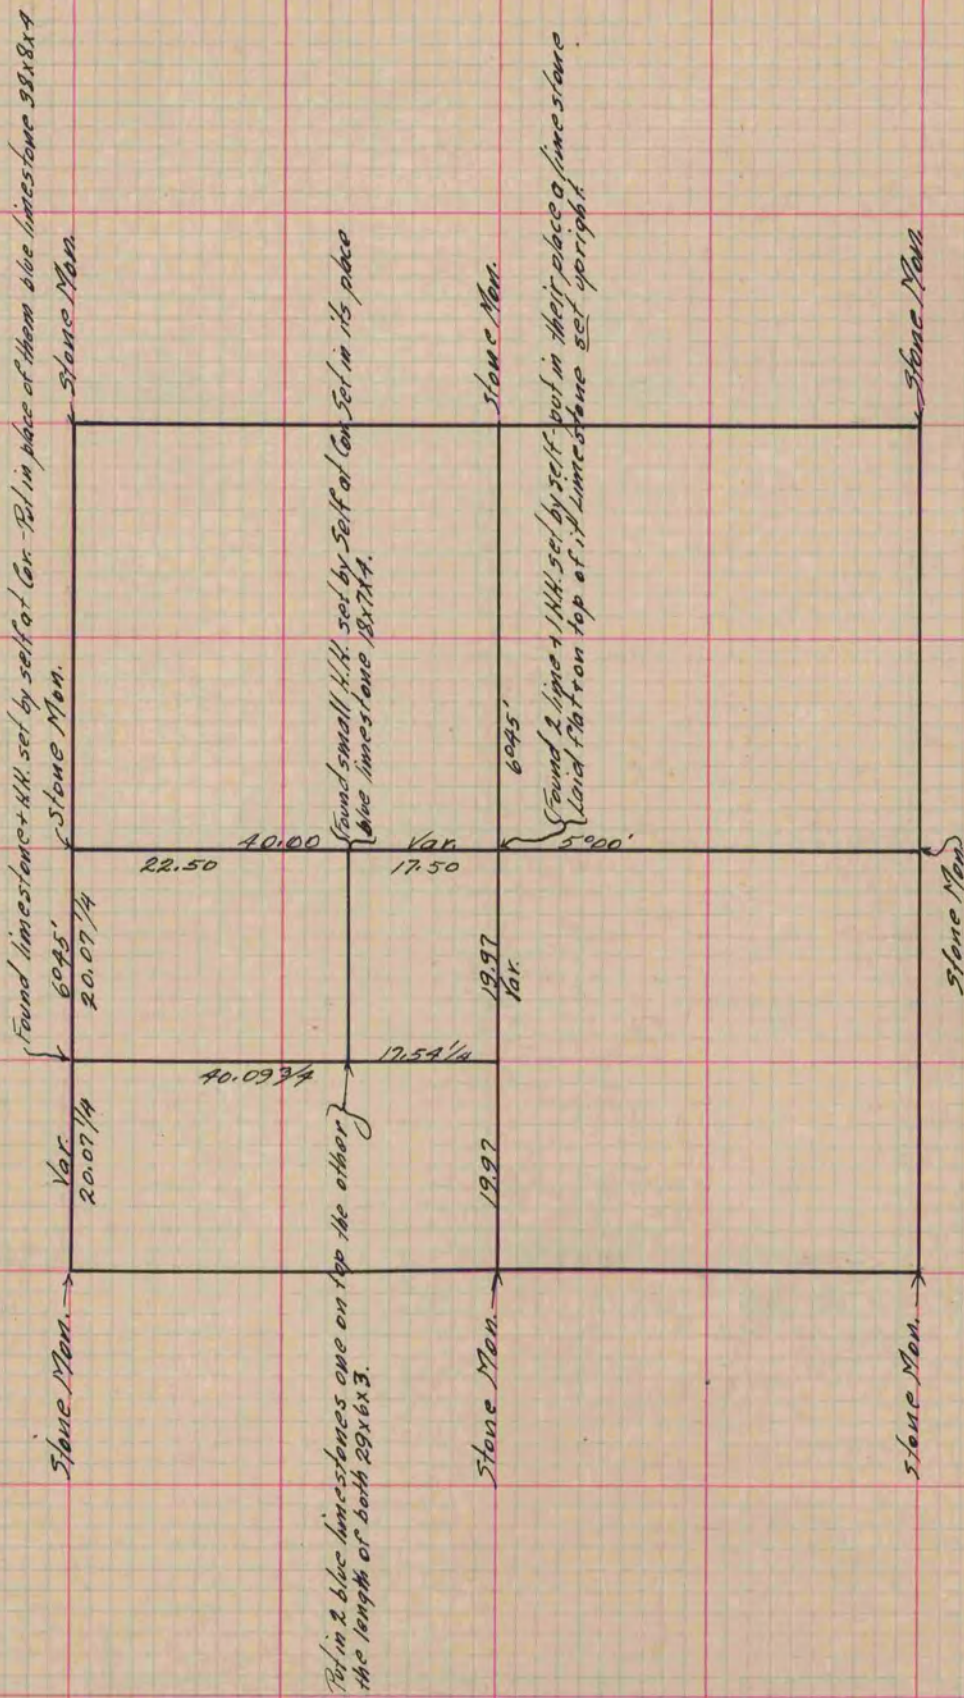

Copied from P. 93 Vol. 2 Original County Surveyors Record.