

# PLAT AND RECORD

Of a Survey on Section 8 T 4 R 12 E. of the 4 P. M. in Fulton Township

Rock County, Wisconsin, made June the 22<sup>nd</sup> 1882


I hereby certify that the following is a correct record of said survey as made by me.

COUNTY BUILDING  
IN CITY OF БЕЛОIT

(Signed) S. F. Holmes.  
SFH

County Surveyor.

*Sec. 8 Fulton, E. & W. 1/4 line.*

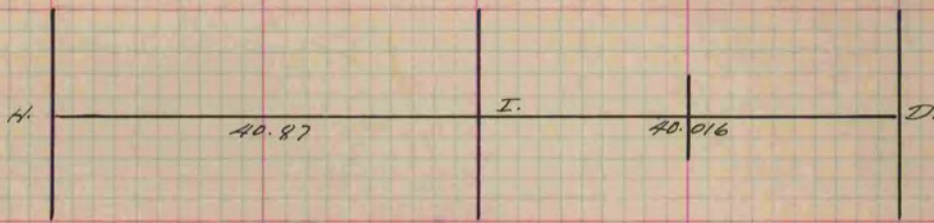

*At D. found stones & stump as described on P. 96. Run line on a Var. 70-15' passing 2ft. N. of 'I.' & at 'H' 6 1/2 lbs. N. of stone at the N. side of fence post. The point H. being not regarded as satisfactory, further investigation was deferred, but shows the men's very nearly in a direct line.*

*Copied from P. 284 Vol. 2 County Surveyor's Record.*