

PLAT AND RECORD


513

Of a Survey on ^{SE 1/4} Section / T 4 R 12 E. of the 4 P. M. in Fulton Township
Rock County, Wisconsin, made Sept. the 6 1899

I hereby certify that the following is a correct record of said survey as made by me.

COUNTY BUILDING
IN CITY OF BELOIT

(Signed) Perry F. Brown
PFB County Surveyor.

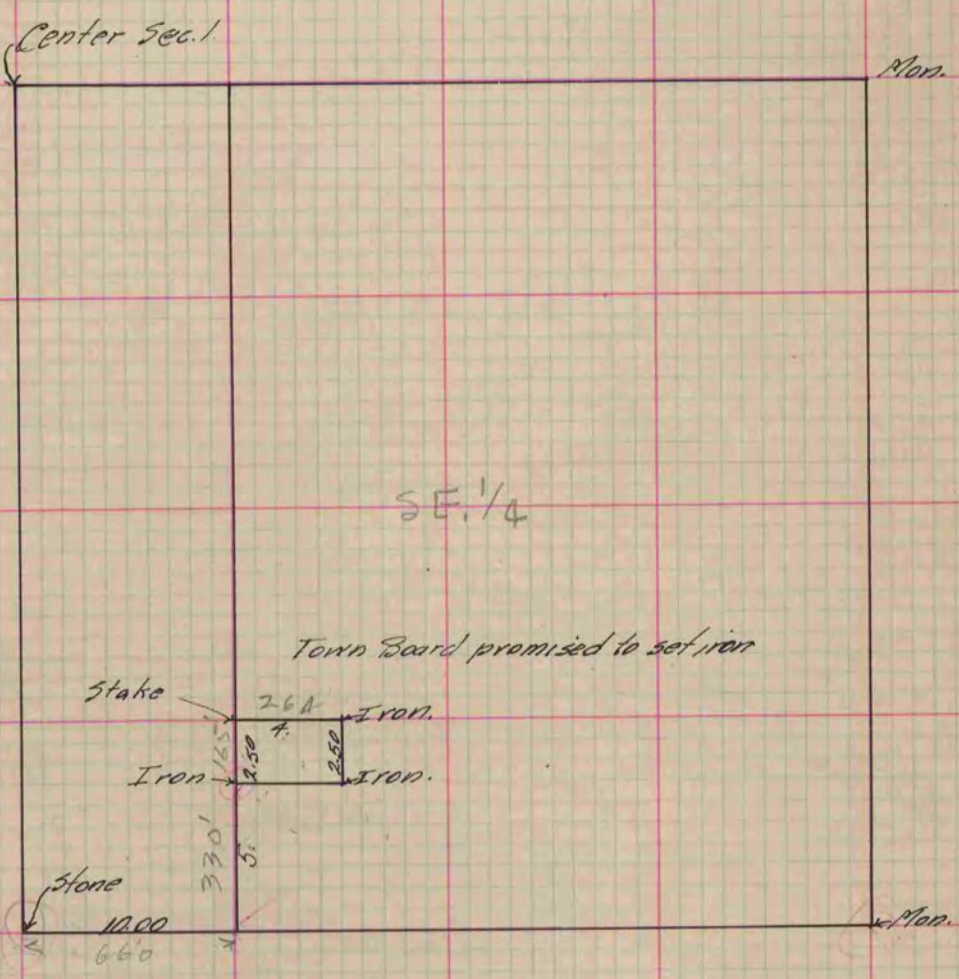

Copied from P. 388 Vol. 2 County Surveyor's Record.

12
m