

PLAT AND RECORD


COUNTY BUILDING
CITY OF JANESVILLE

VOL. 6


Of a Survey on Section 2 T 4 R 13 E of the 4 P. M. in Township

Rock County, Wisconsin, made May the

I hereby certify that the following is a correct record of said survey as made by me

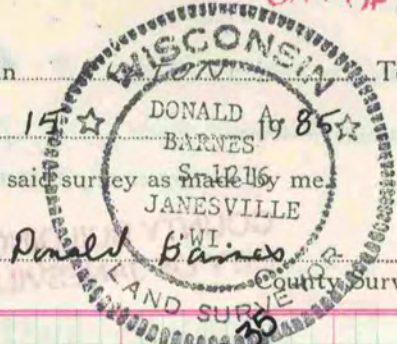

Donald Barnes
County Surveyor.

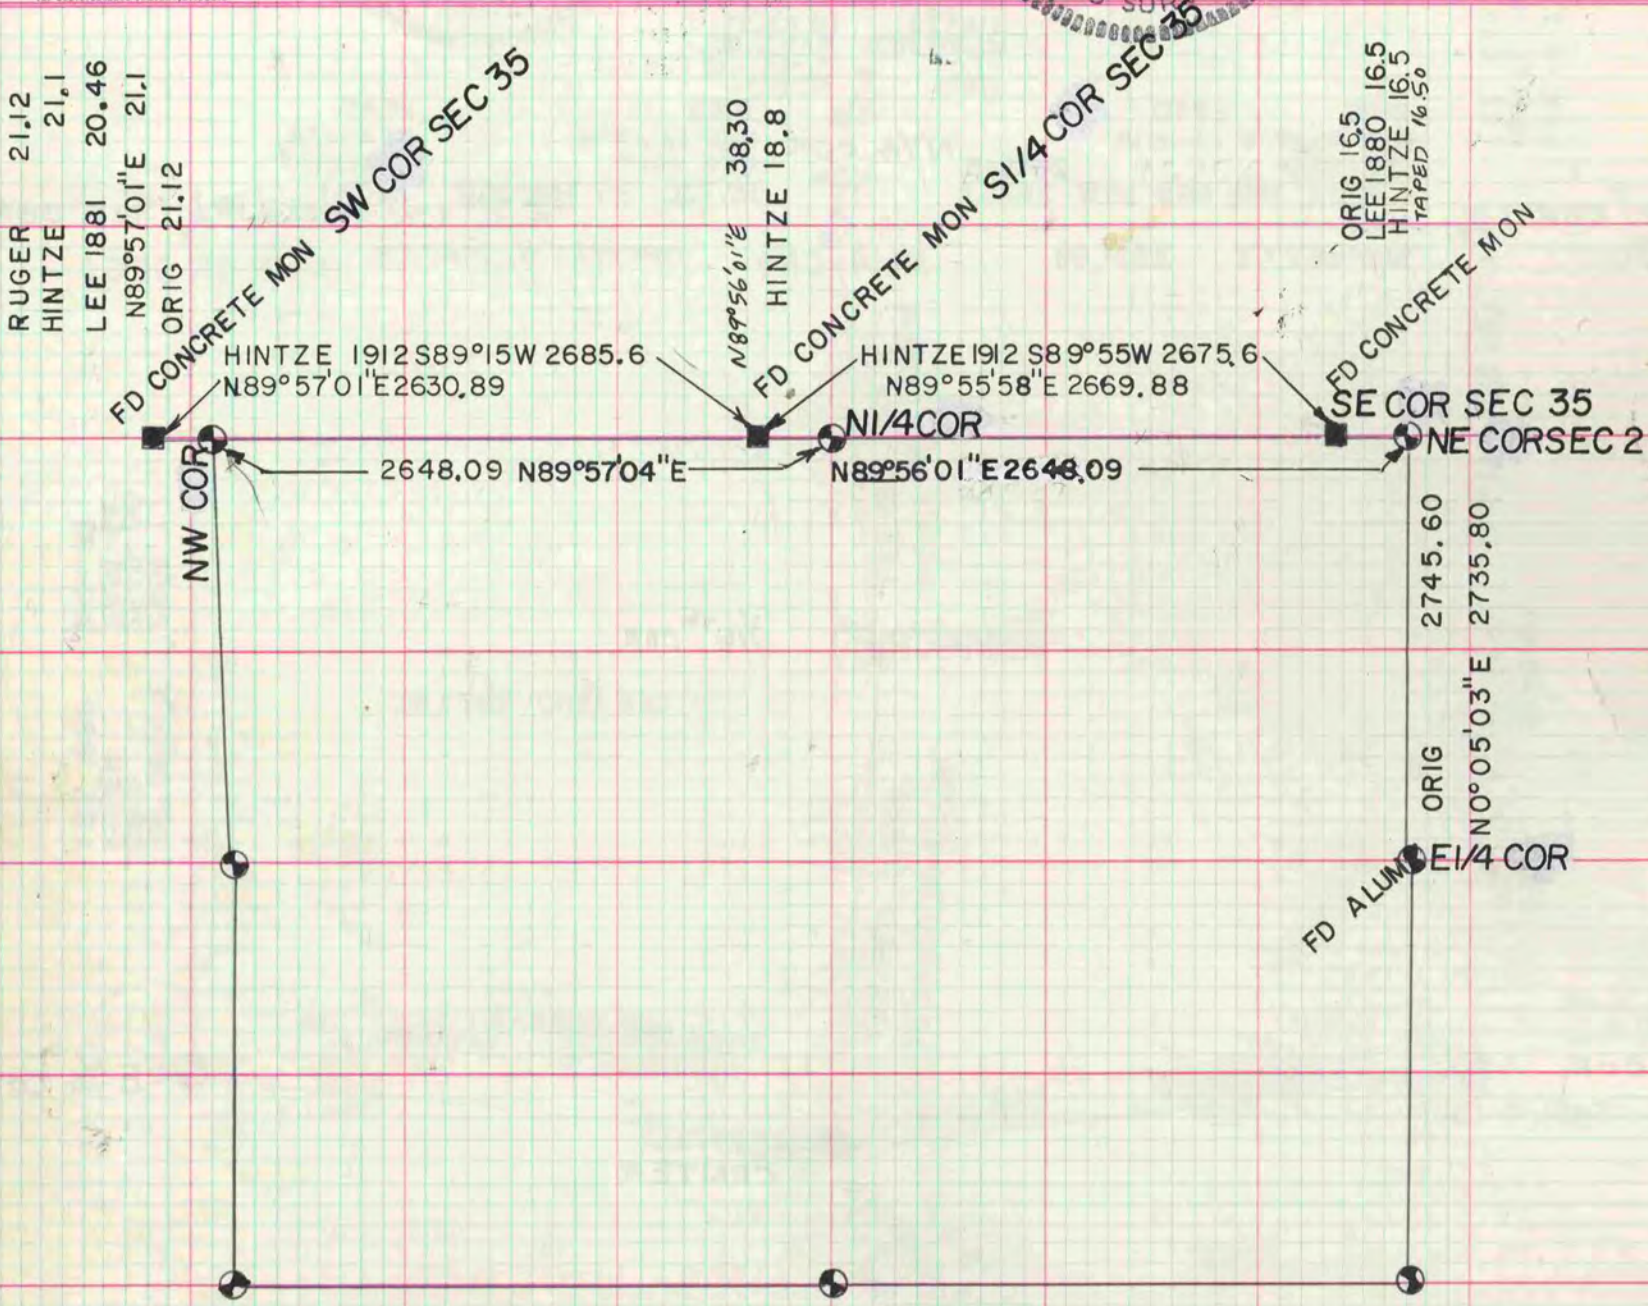

MICROFILMED