

PLAT AND RECORD

COUNTY BUILDING
CITY OF JANESVILLE

COUNTY BUILDING
CITY OF JANESVILLE


Of a Survey on Section 15 T 4 R 11 E. of the 4 P. M. in PORTER Township

Rock County, Wisconsin, made AUG the 25 1965

I hereby certify that the following is a correct record of said survey as made by me.

MICROFILMED *R.H.B. [Signature]*

County Surveyor.

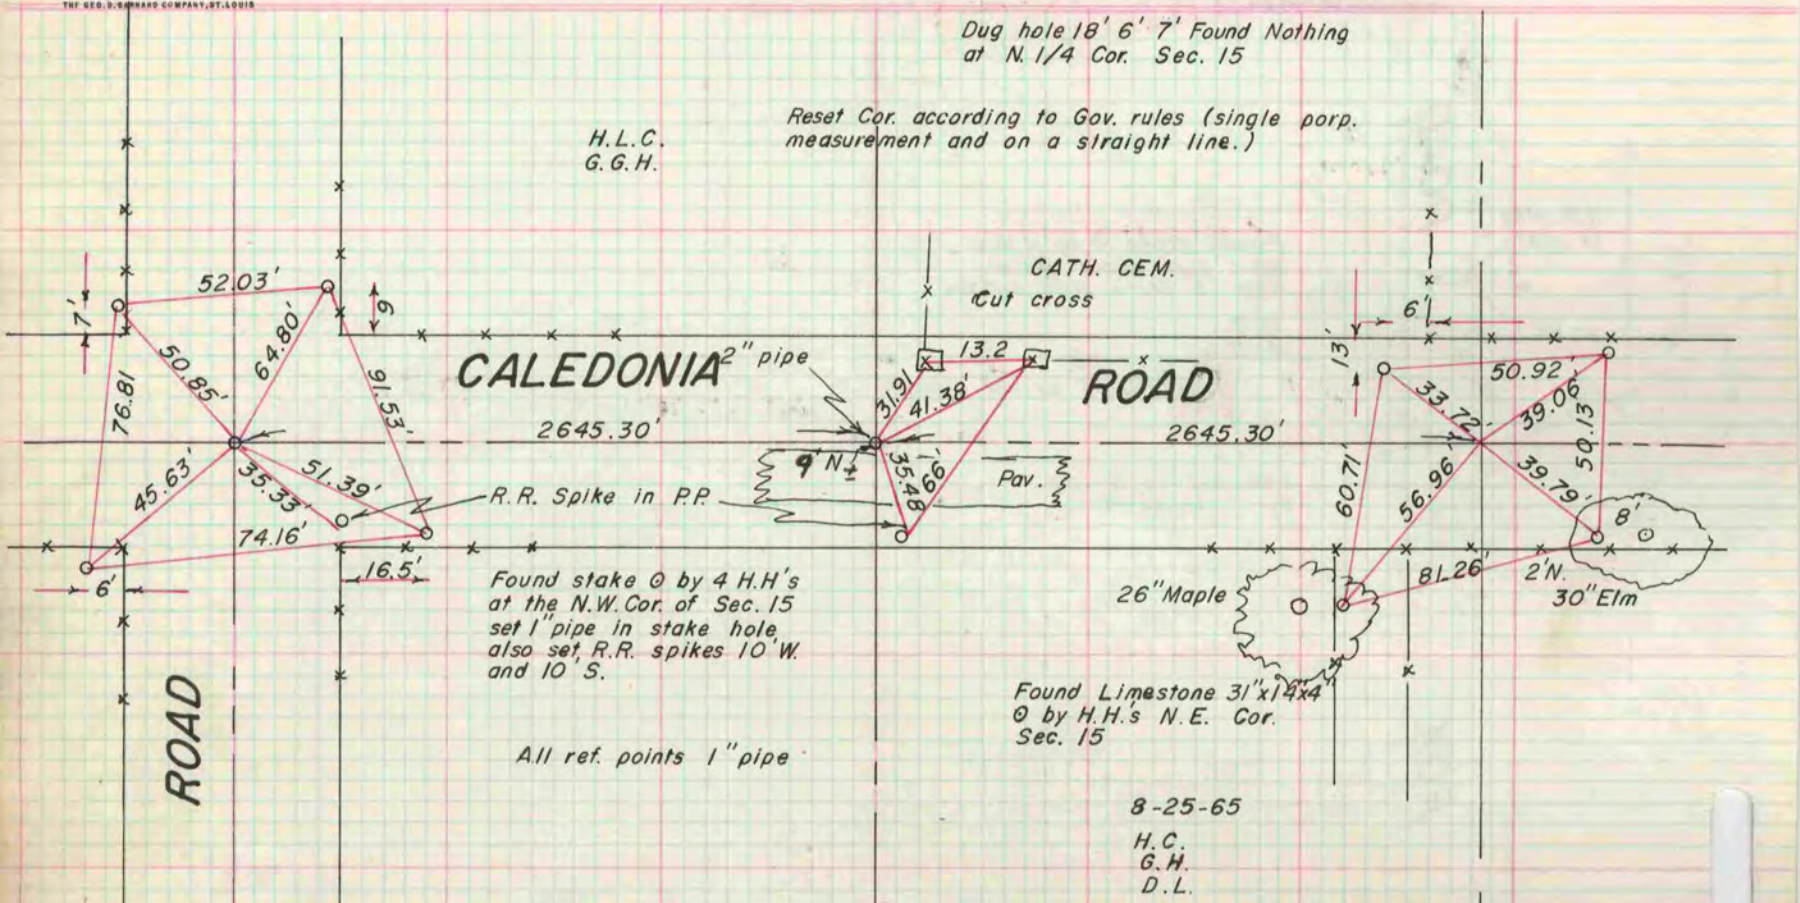

15

