

PLAT AND RECORD

V-4 127

COUNTY BUILDING
CITY OF JANESVILLE

PG 124 BELoit
REC 12/8/75 DAB

Of a Survey on Section 5, 6, 7, 8 T. 2 R. 10 E. of the 4 P. M. in SPRINGVALLY Township

Rock County, Wisconsin, made the 19


I hereby certify that the following is a correct record of said survey as made by me.

RWB Atkinson
County Surveyor.

MICROFILMED

THE GEO. D. BARNARD COMPANY, ST. LOUIS

Page 126
in Beloit

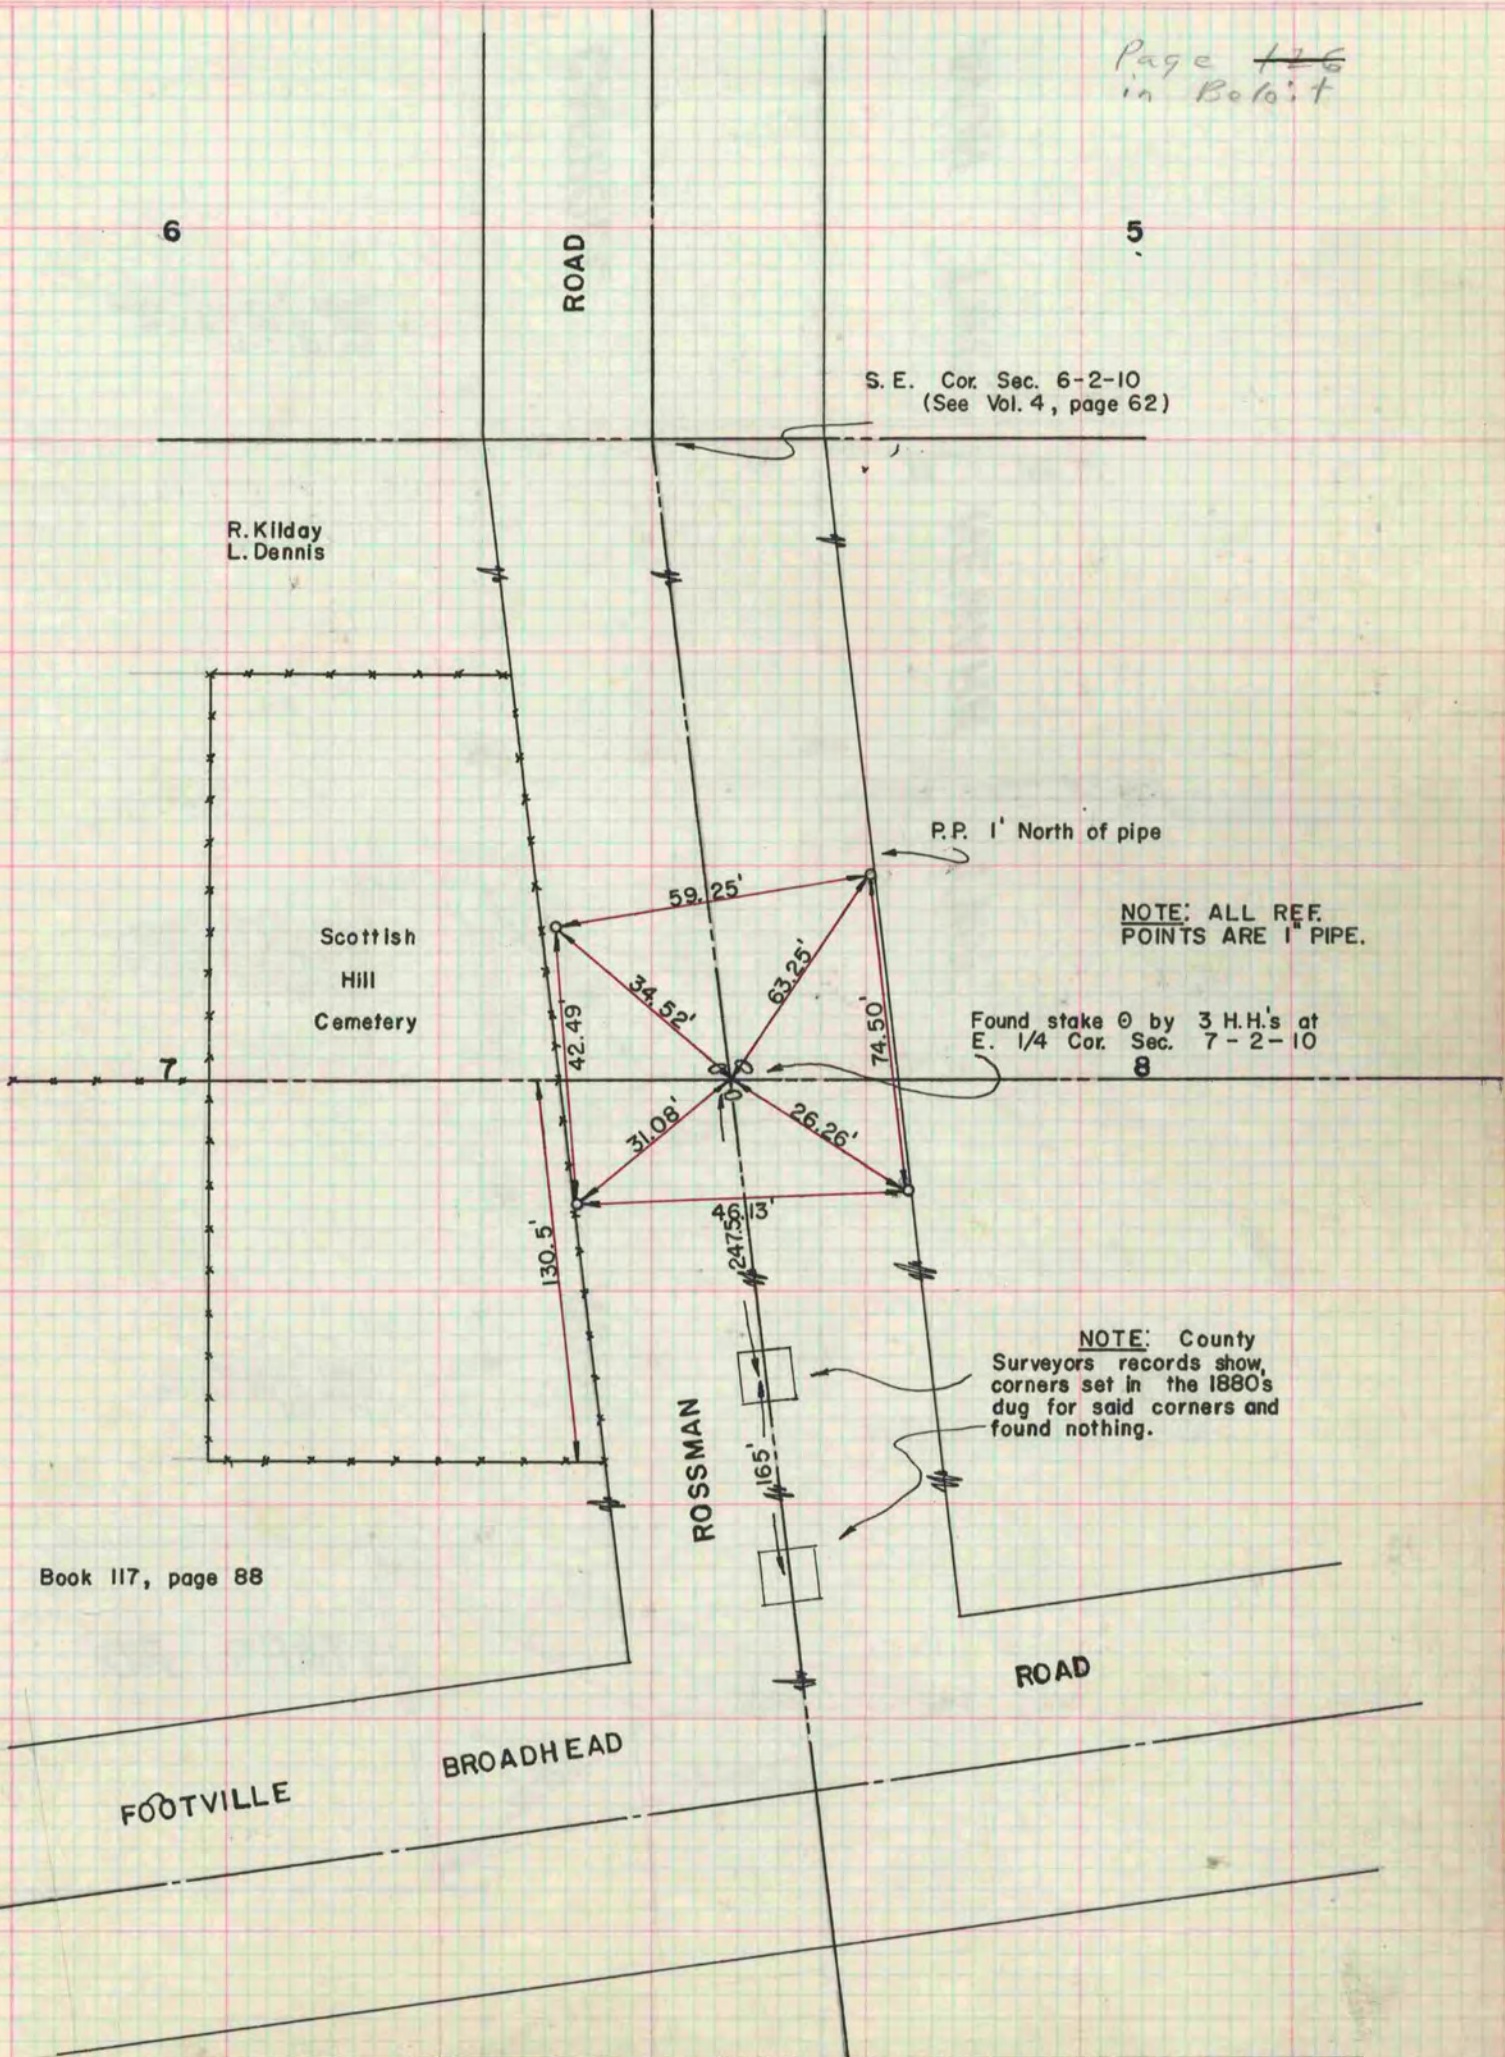

124 in Beloit