

PLAT AND RECORD


235

VOL. 6


Of a Survey on Section **23** T **3** R **14** E. of the 4 P. M. in **JOHNSTOWN** Township
Rock County, Wisconsin, made **NOV** the **30** 18**81**

I hereby certify that the following is a correct record of said survey made by me.
COUNTY BUILDING
CITY OF JANESVILLE

Donald A. ...

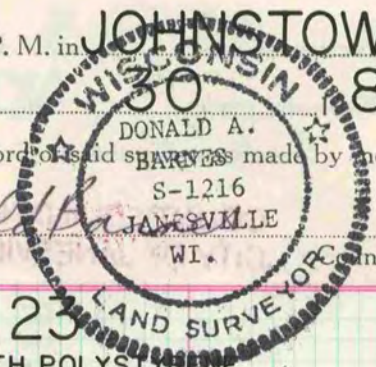


N1/4 COR SEC 23
FOUND 1" IRON PIPE REPLACED WITH POLYSTYRENE MON.

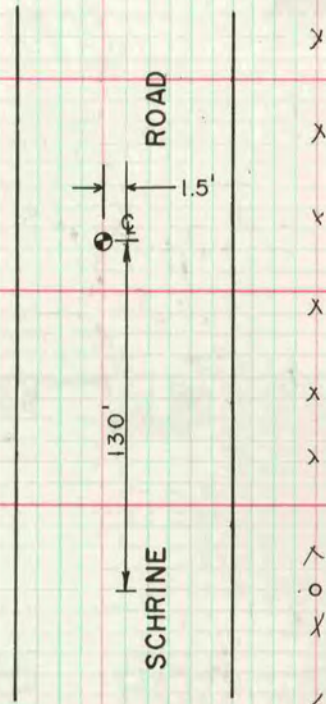

x
x
FOUND IRON PIPE CSM VOL 6 PG 246

CENTER COR SEC 23
FOUND 1" IRON PIPE

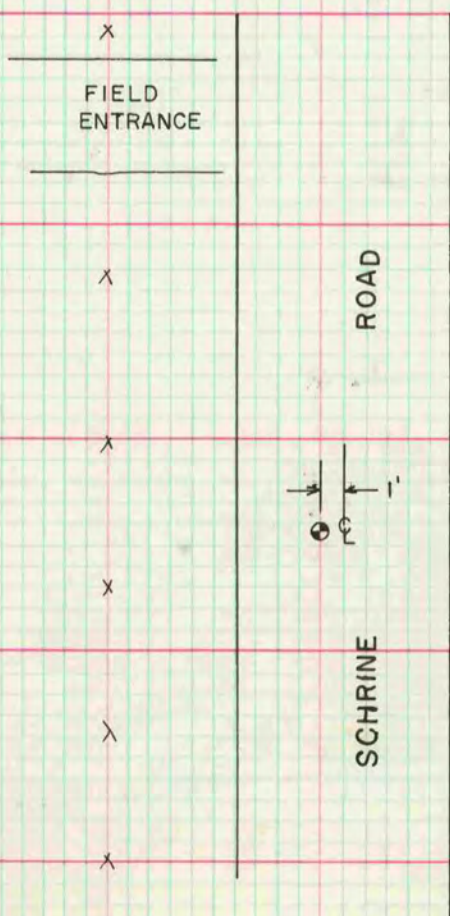

x
x
MICROFILMED