

MICROFILMED PLAT AND RECORD

175
V-2

COUNTY BUILDING
CITY OF JANESVILLE

Of a Survey on Section 20 T 2 R 12 E. of the 4 P. M. in Rock Township


Rock County, Wisconsin, made November the 18th 1874

I hereby certify that the following is a correct record of said survey as made by me.

(Signed) Edward Roger
R.H.B. County Surveyor.

The survey was made to establish the North & South quarter line. The stakes on the quarter line were not driven to Establish Corners, but simply to mark the quarter line.

Found old stake & H.H. stone on W. side of it.
Drove new stake in place of old one & @ it
with 4 H.H. stones

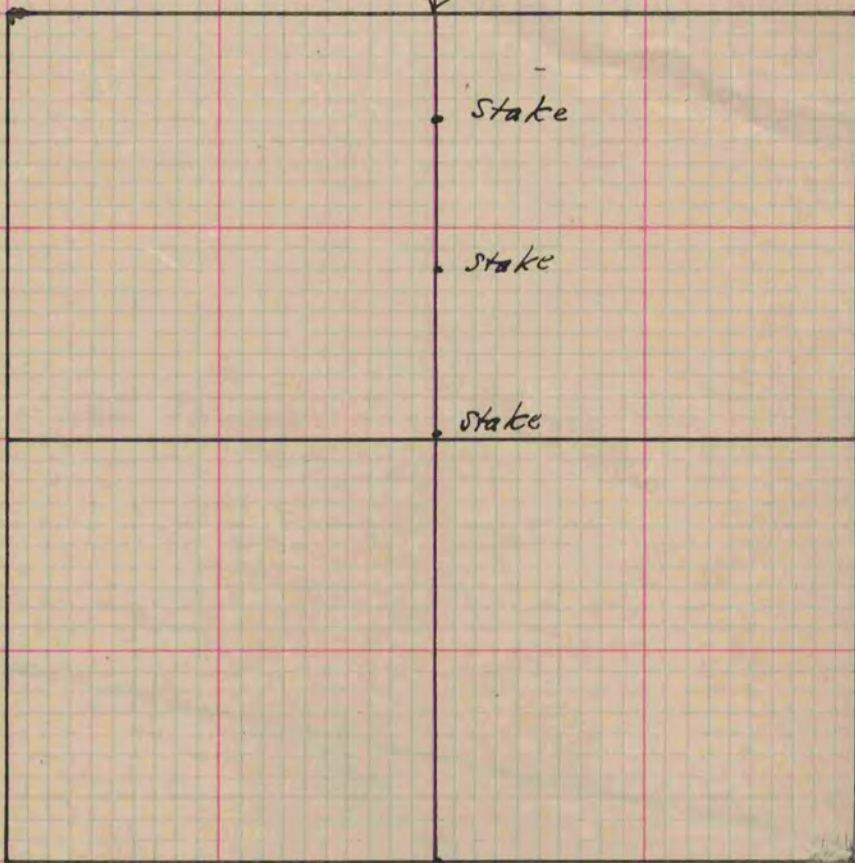

Found Cor. Est. by self in former survey
Drove new stake deep, laid flat lime stone
on top of stake & put on top of that lime
stone a limestone 10 x 5 x 12 1/2

Copied from page 131 Vol. 2. Original County Surveyors Record.