


PLAT AND RECORD

Of a Survey on Section 24 T 3 R 13 E. of the 4 P. M. in Harmony Township
Rock County, Wisconsin, made April the 16th 1891

COUNTY BUILDING
CITY OF JANESVILLE

I hereby certify that the following is a correct record of said survey as made by me.

(Signed) O. G. Bleedorn Dep.
R. H. B. County Surveyor.

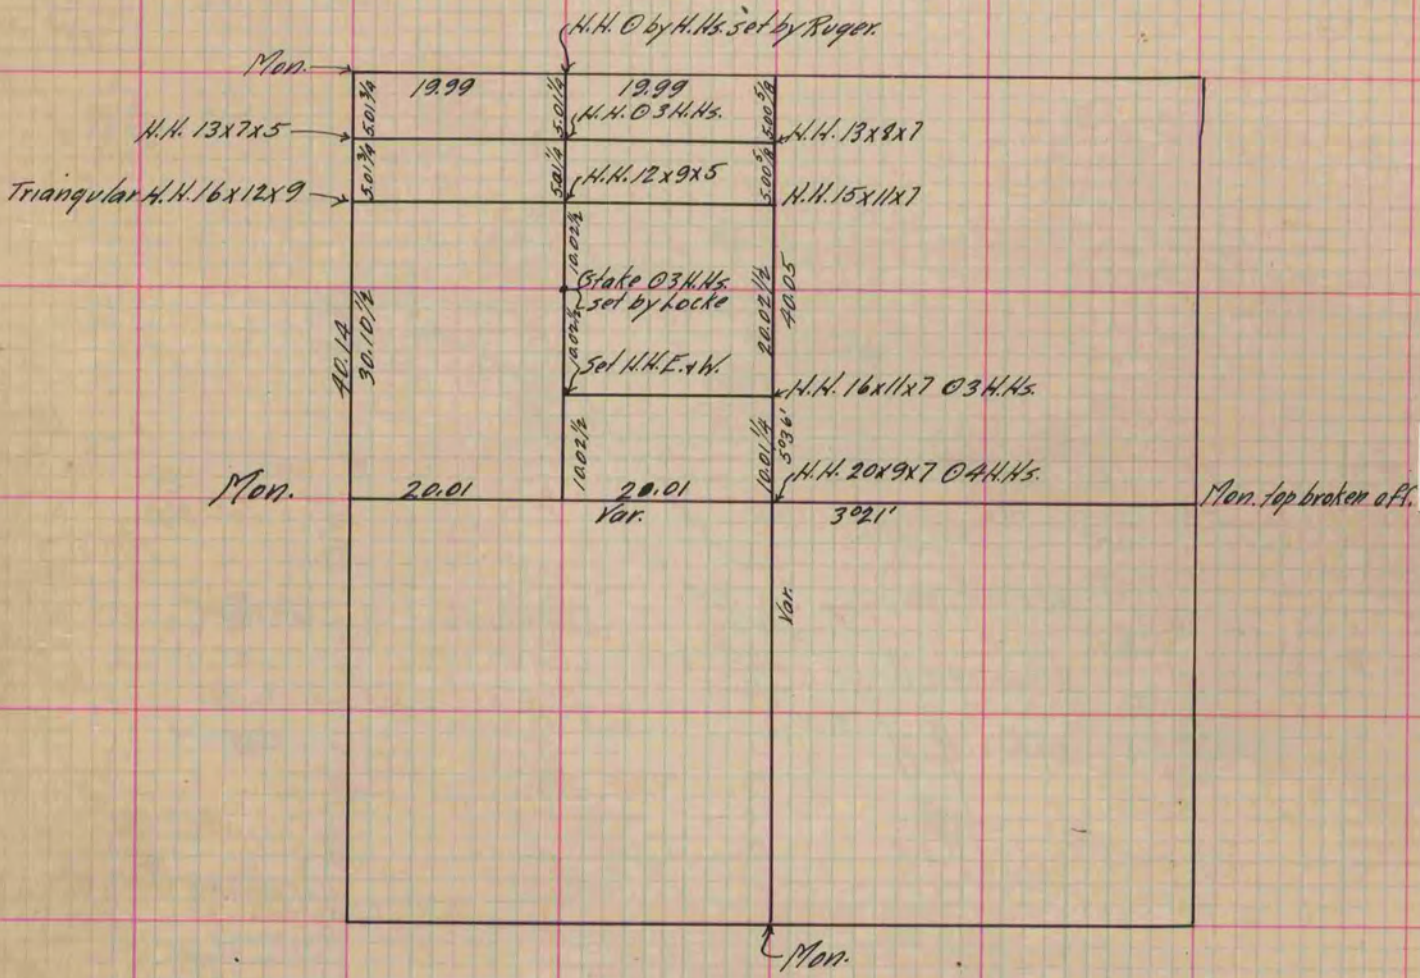

Copied from P. 355 Vol. 2 County Surveyor's Record