

MICROFILMED

PLAT AND RECORD

133

V-1


COUNTY BUILDING
CITY OF JANESVILLE

Of a Survey on Section 6 T 3 R 13 E. of the 4 P. M. in Harmony Township

Rock County, Wisconsin, made May the 24th 1860

I hereby certify that the following is a correct record of said survey as made by me.

(Signed) Edward Ruger
R.T.D. County Surveyor.

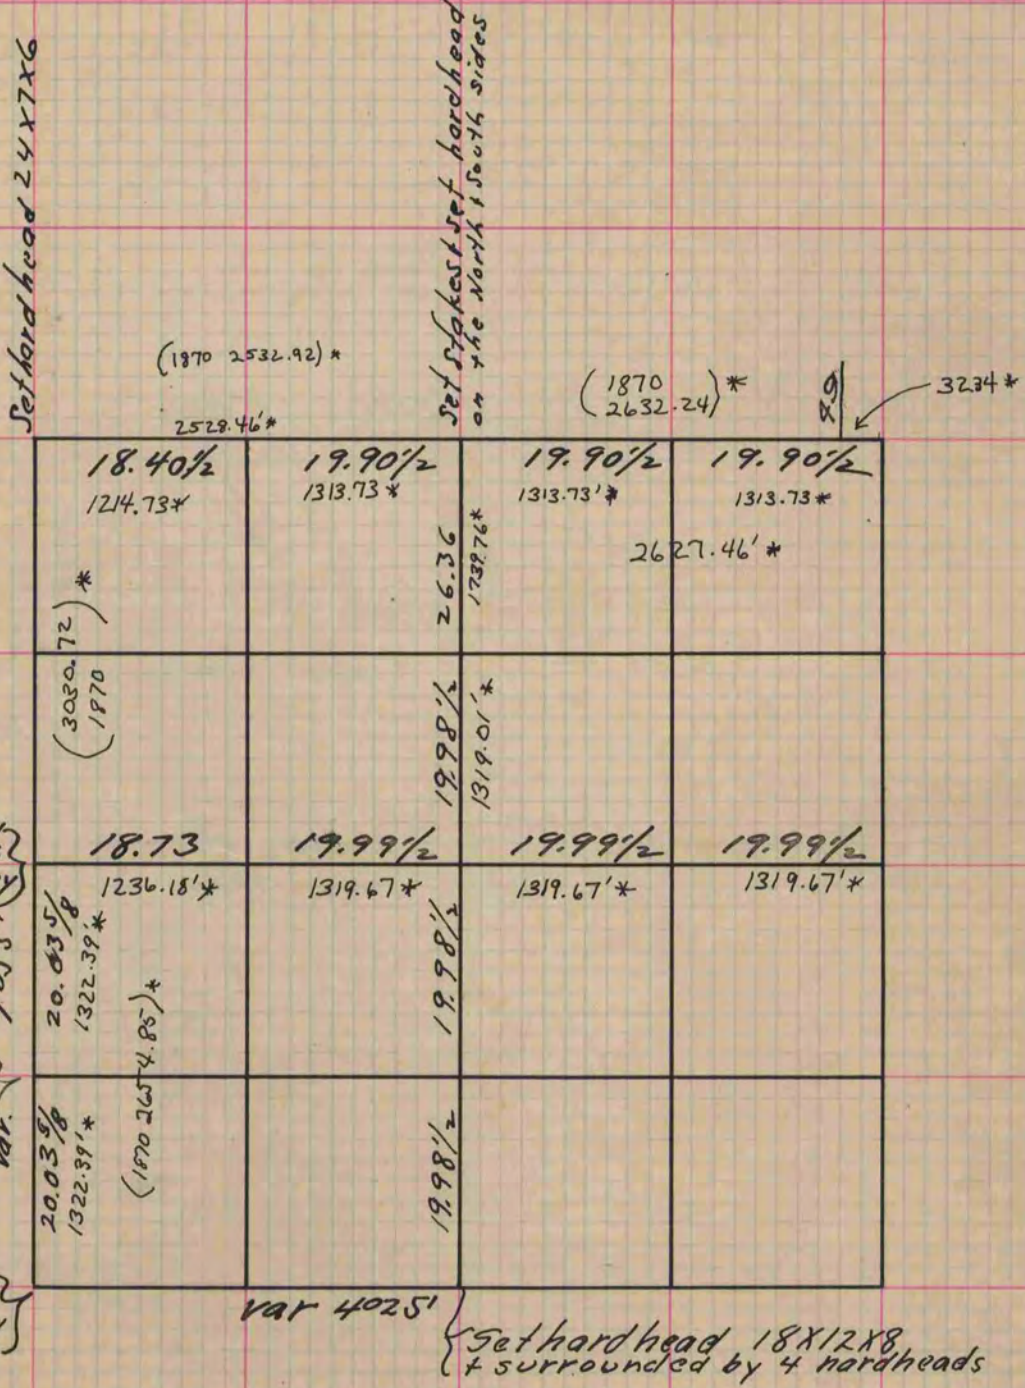

* Copied from the
Beloit records
12/9/75 G.O.

Copied from Page 142 County Surveyors Record