

# PLAT AND RECORD

COUNTY BUILDING  
CITY OF JANESVILLE

Of a Survey on Section 15, 23 T 1 R 13 E. of the 4 P. M. in TURTLE Township  
Rock County, Wisconsin, made SEP the 15 1977


I hereby certify that the following is a correct record of said survey as made by me.



## W 1/4 COR SEC 15

FD ALUM CAP IN CONCRETE WITH A HOLE IN THE CENTER. THE HOLE IS NOT CORRECT. THE LAST "N" IN WISCONSIN IS THE CORRECT POINT.

○ FD ALUM CAP IN CONCRETE

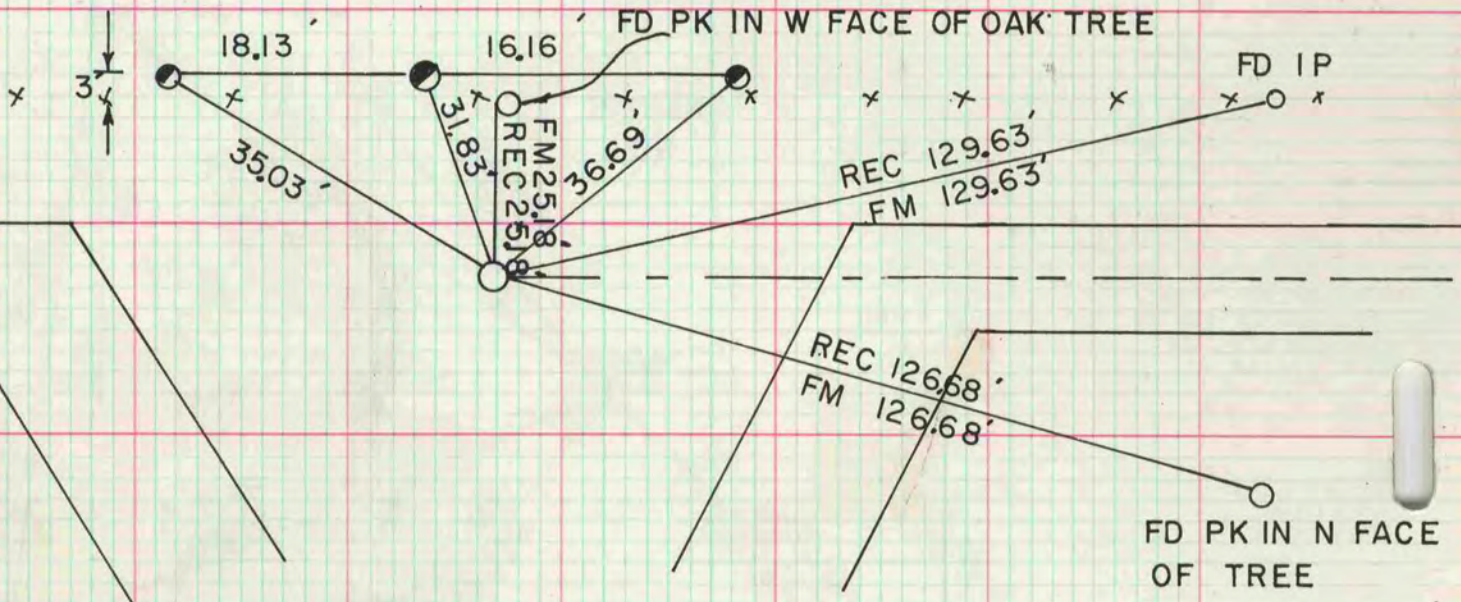

SECTION	CORNER	MON FOUND	REMARKS
24	SE	PK	ALSO FD REF TIES. SET ALUM MON
23	S 1/4	1" IP	SET ALUM MON

MICROFILMED