

# PLAT AND RECORD

323  
V-4

3-4  
Of a Survey on Section 9-10 T 4N R 11 E. of the 4 P. M. in PORTER Township  
Rock County, Wisconsin, made JUNE the 12 1967


I hereby certify that the following is a correct record of said survey as made by me.

**MICROFILMED**

*R. B. Batteman*

County Surveyor.

COUNTY BUILDING  
CITY OF JANESVILLE

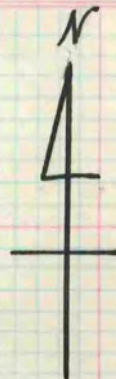

ROAD



NW COR SEC 10  
DUG LARGE HOLE  
FOUND NOTHING

6-12-67  
H.C.  
O.S.  
L.M.



CASEY