

PLAT AND RECORD

233


V-4

Of a Survey on Section 33 T 1 R 11 E. of the 4 P. M. in NEWARK Township

Rock County, Wisconsin, made AUGUST the 24th 1965

I hereby certify that the following is a correct record of said survey as made by me.

COUNTY BUILDING
CITY OF JANESVILLE

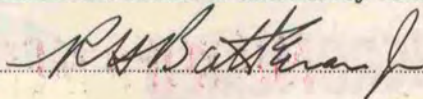

County Surveyor.

MICROFILMED

THE GEO. D. BARRARD COMPANY, ST. LOUIS

