

PLAT AND RECORD

345



VOL. 6

Of a Survey on Section **32** T **3** R **10** E. of the 4 P. M. in **MAGNOLIA** Township
Rock County, Wisconsin, made **AUGUST** the **7** 19 **85**

I hereby certify that the following is a correct record of said survey as made by me.

Donald Barney
County Surveyor.

COUNTY BUILDING
CITY OF JANESVILLE

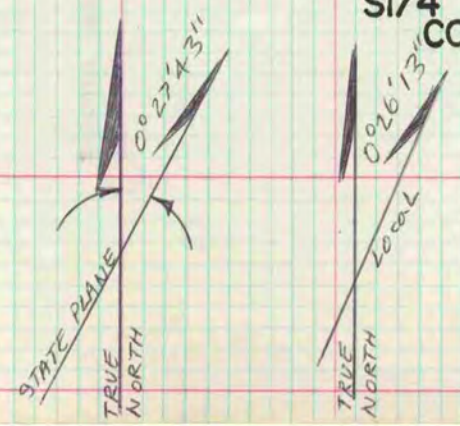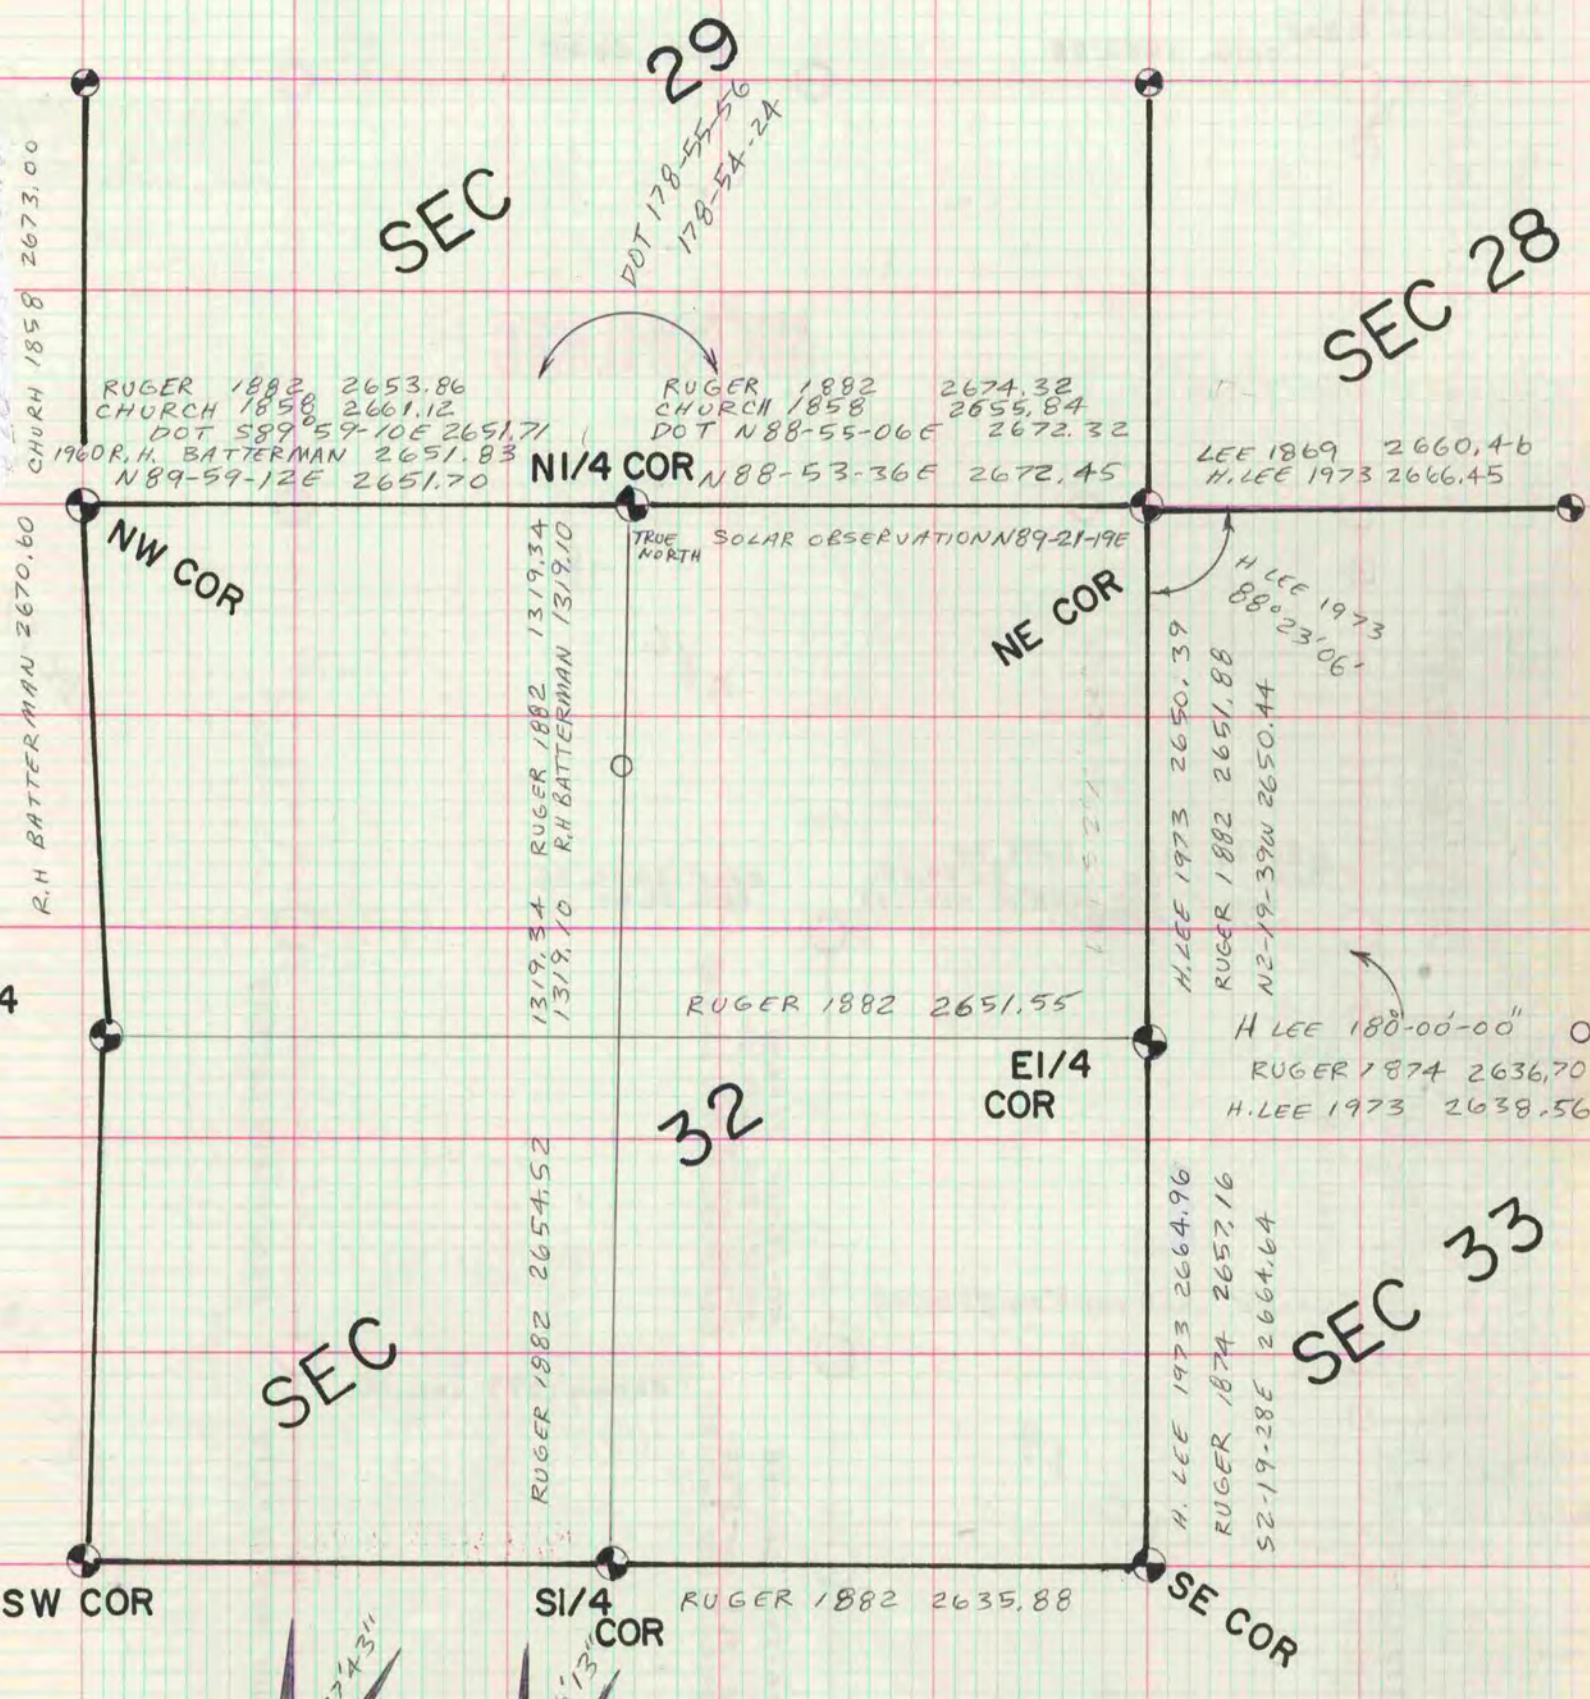

MICROFILMED