

**MICROFILMED**

# PLAT AND RECORD


Of a Survey on Section 34 T 4 R 11 E. of the 4 P. M. in Porter Township

Rock County, Wisconsin, made March 30<sup>th</sup> the 1861

I hereby certify that the following is a correct record of said survey as made by me.

COUNTY BUILDING  
CITY OF JANESVILLE

(Signed) Edward Roger  
R.H.B. County Surveyor.

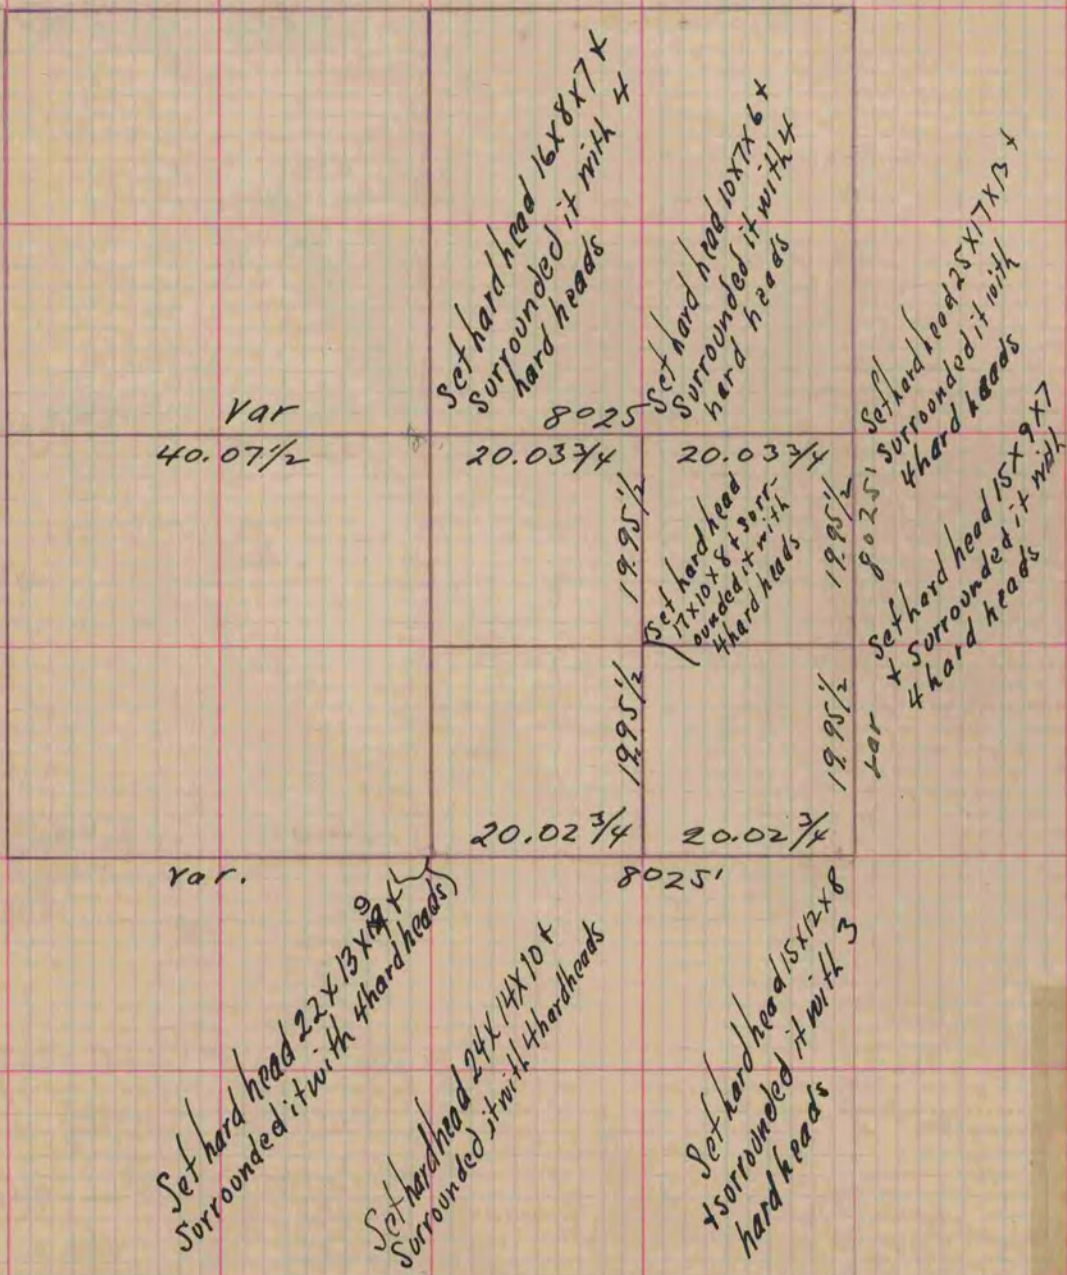

Copied from Page 165 Vol. One Original County Surveyors Record