

PLAT AND RECORD

161

V-5

COUNTY BUILDING
CITY OF JANESVILLE

Of a Survey on Section 2 N T 4 R 10 E. of the 4 P. M. in UNION Township


Rock County, Wisconsin, made JANUARY the 1975

I hereby certify that the following is a correct record of said survey as made by me.

MICROFILMED

Donald A Barnes

County Surveyor.

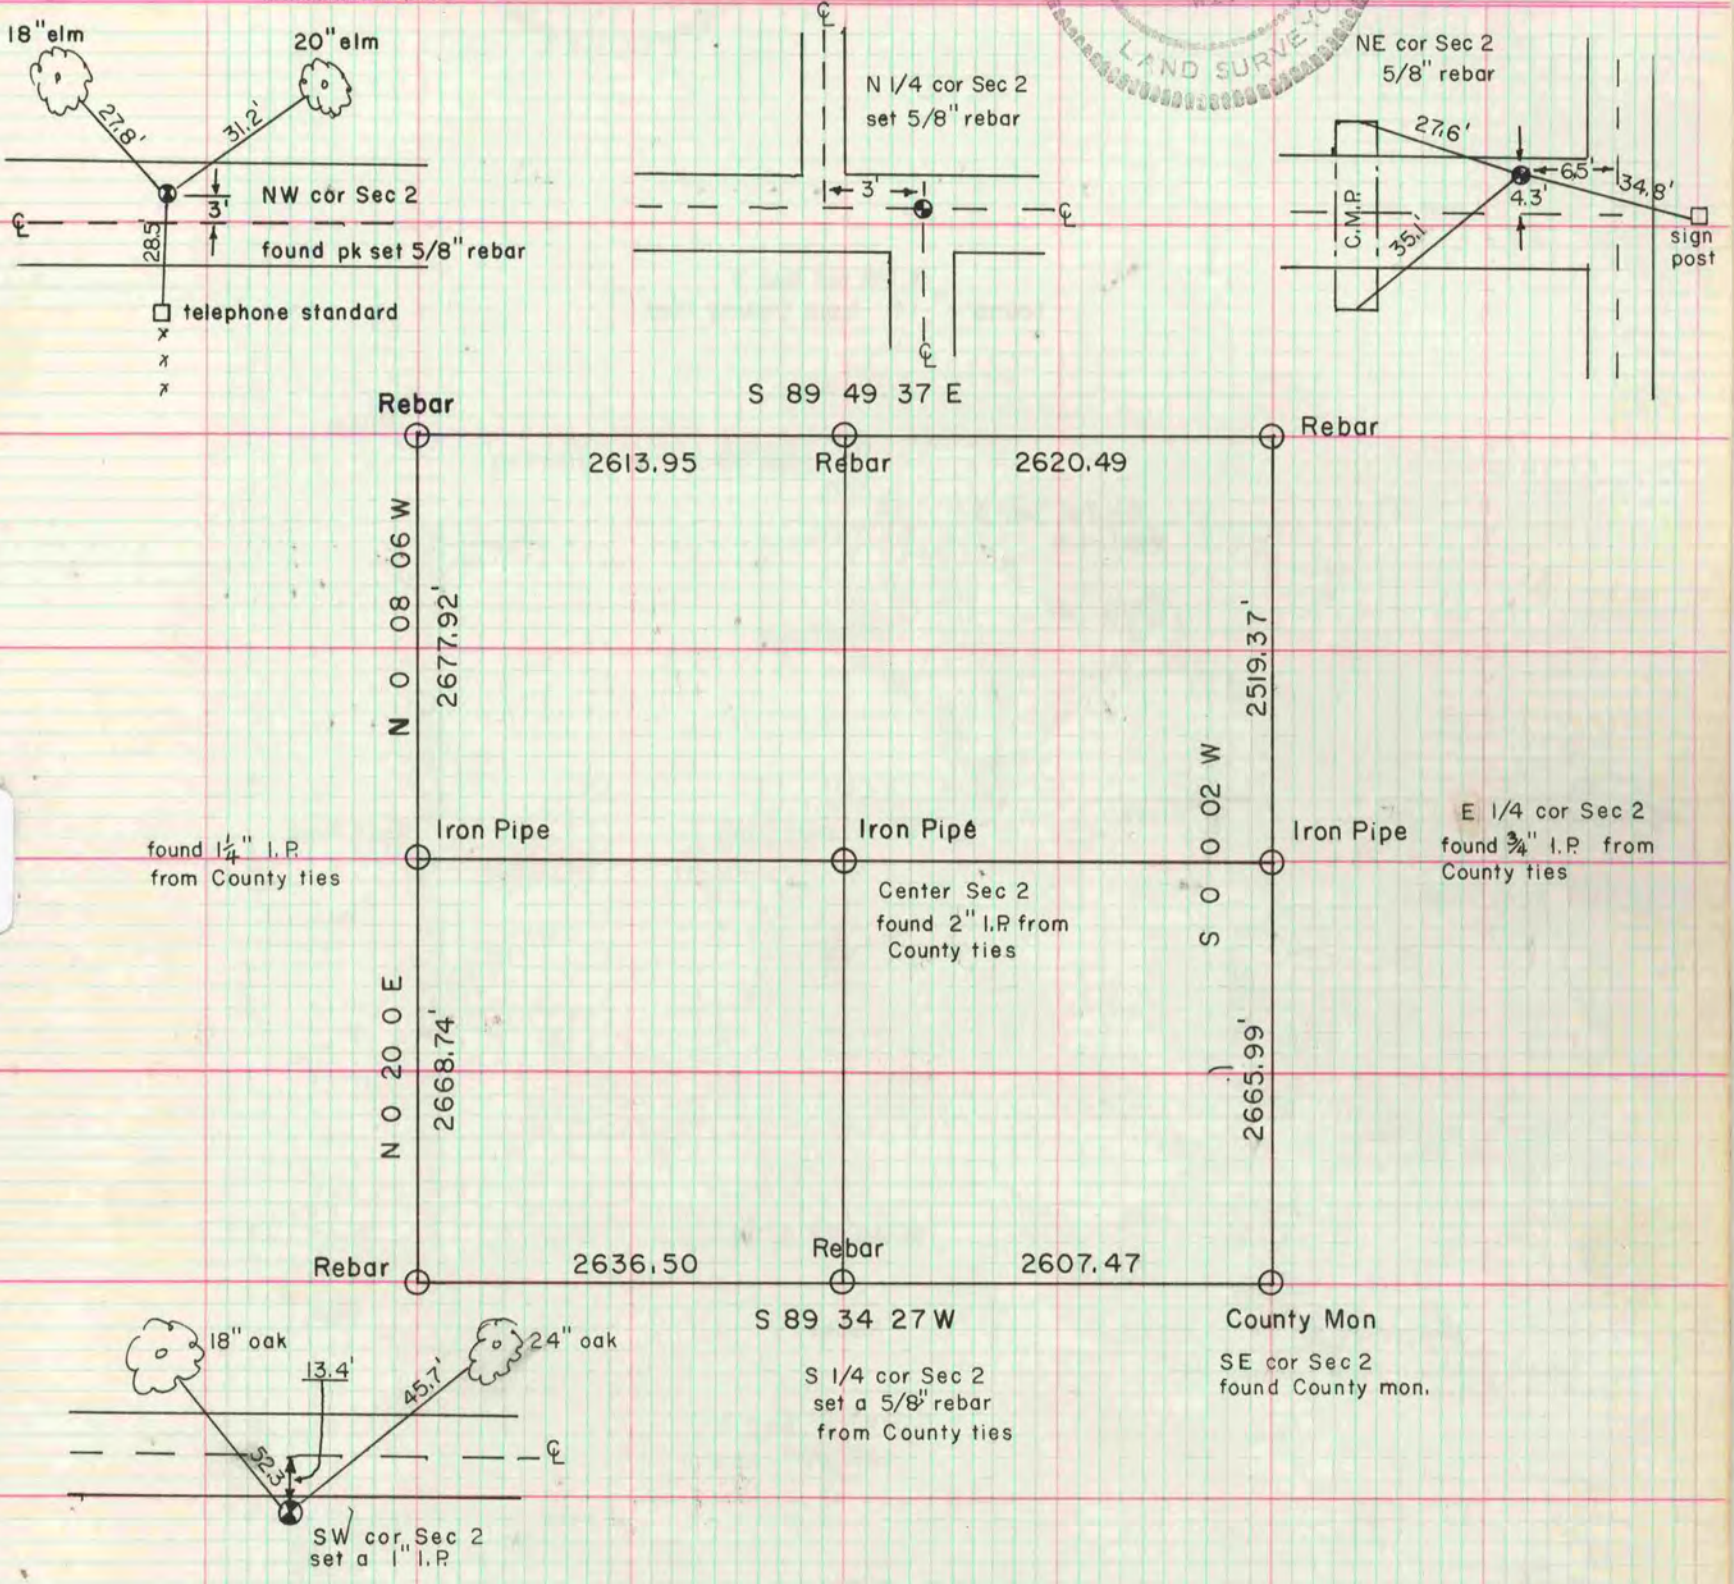

Division
Information supplied by ~~Bureau~~ of Land
Management. Kermit Wilhelm - Supervisory
Land Surveyor