

**MICROFILMED**

# PLAT AND RECORD

Of a Survey on Section 15 T 2 R 12 E. of the 4 P. M. in Rock Township


Rock County, Wisconsin, made June the 8<sup>th</sup> 1861

I hereby certify that the following is a correct record of said survey as made by me.

COUNTY BUILDING  
CITY OF JANESVILLE

(Signed) Edward Ruger  
R.H.B.

County Surveyor.

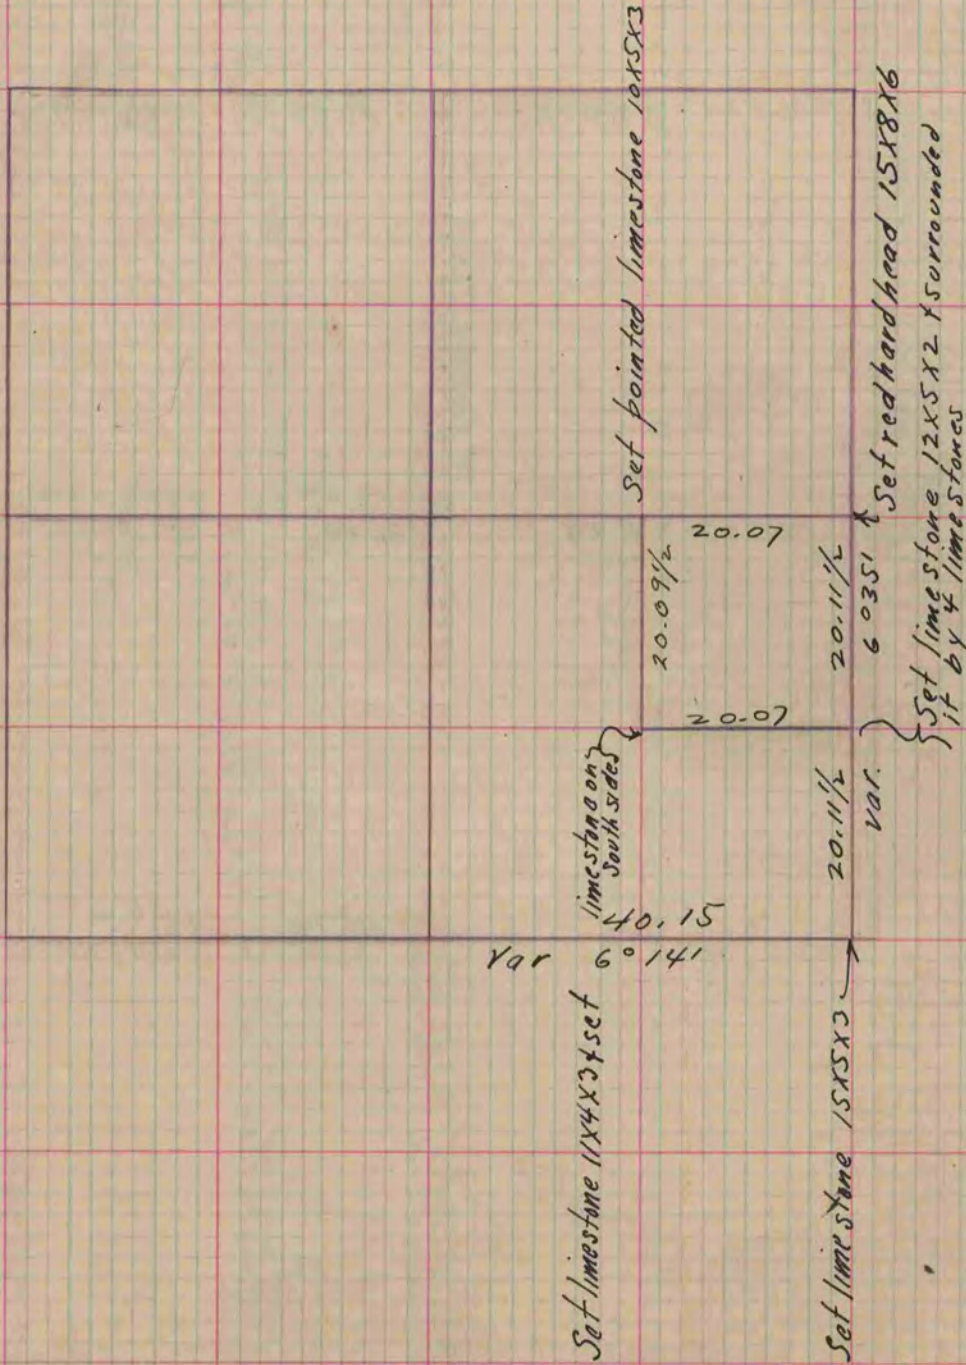

Copied from Page 177 Vol. 1. Original County Surveyors Record