

PLAT AND RECORD


MICROFILMED

COUNTY BUILDING
CITY OF JANESVILLE

Of a Survey on Section 12 T 2 R 13 E. of the 4 P. M. in La Prairie Township
Rock County, Wisconsin, made June the 7th 1861

I hereby certify that the following is a correct record of said survey as made by me.

(Signed) Edward Roger
R.H.B. County Surveyor.

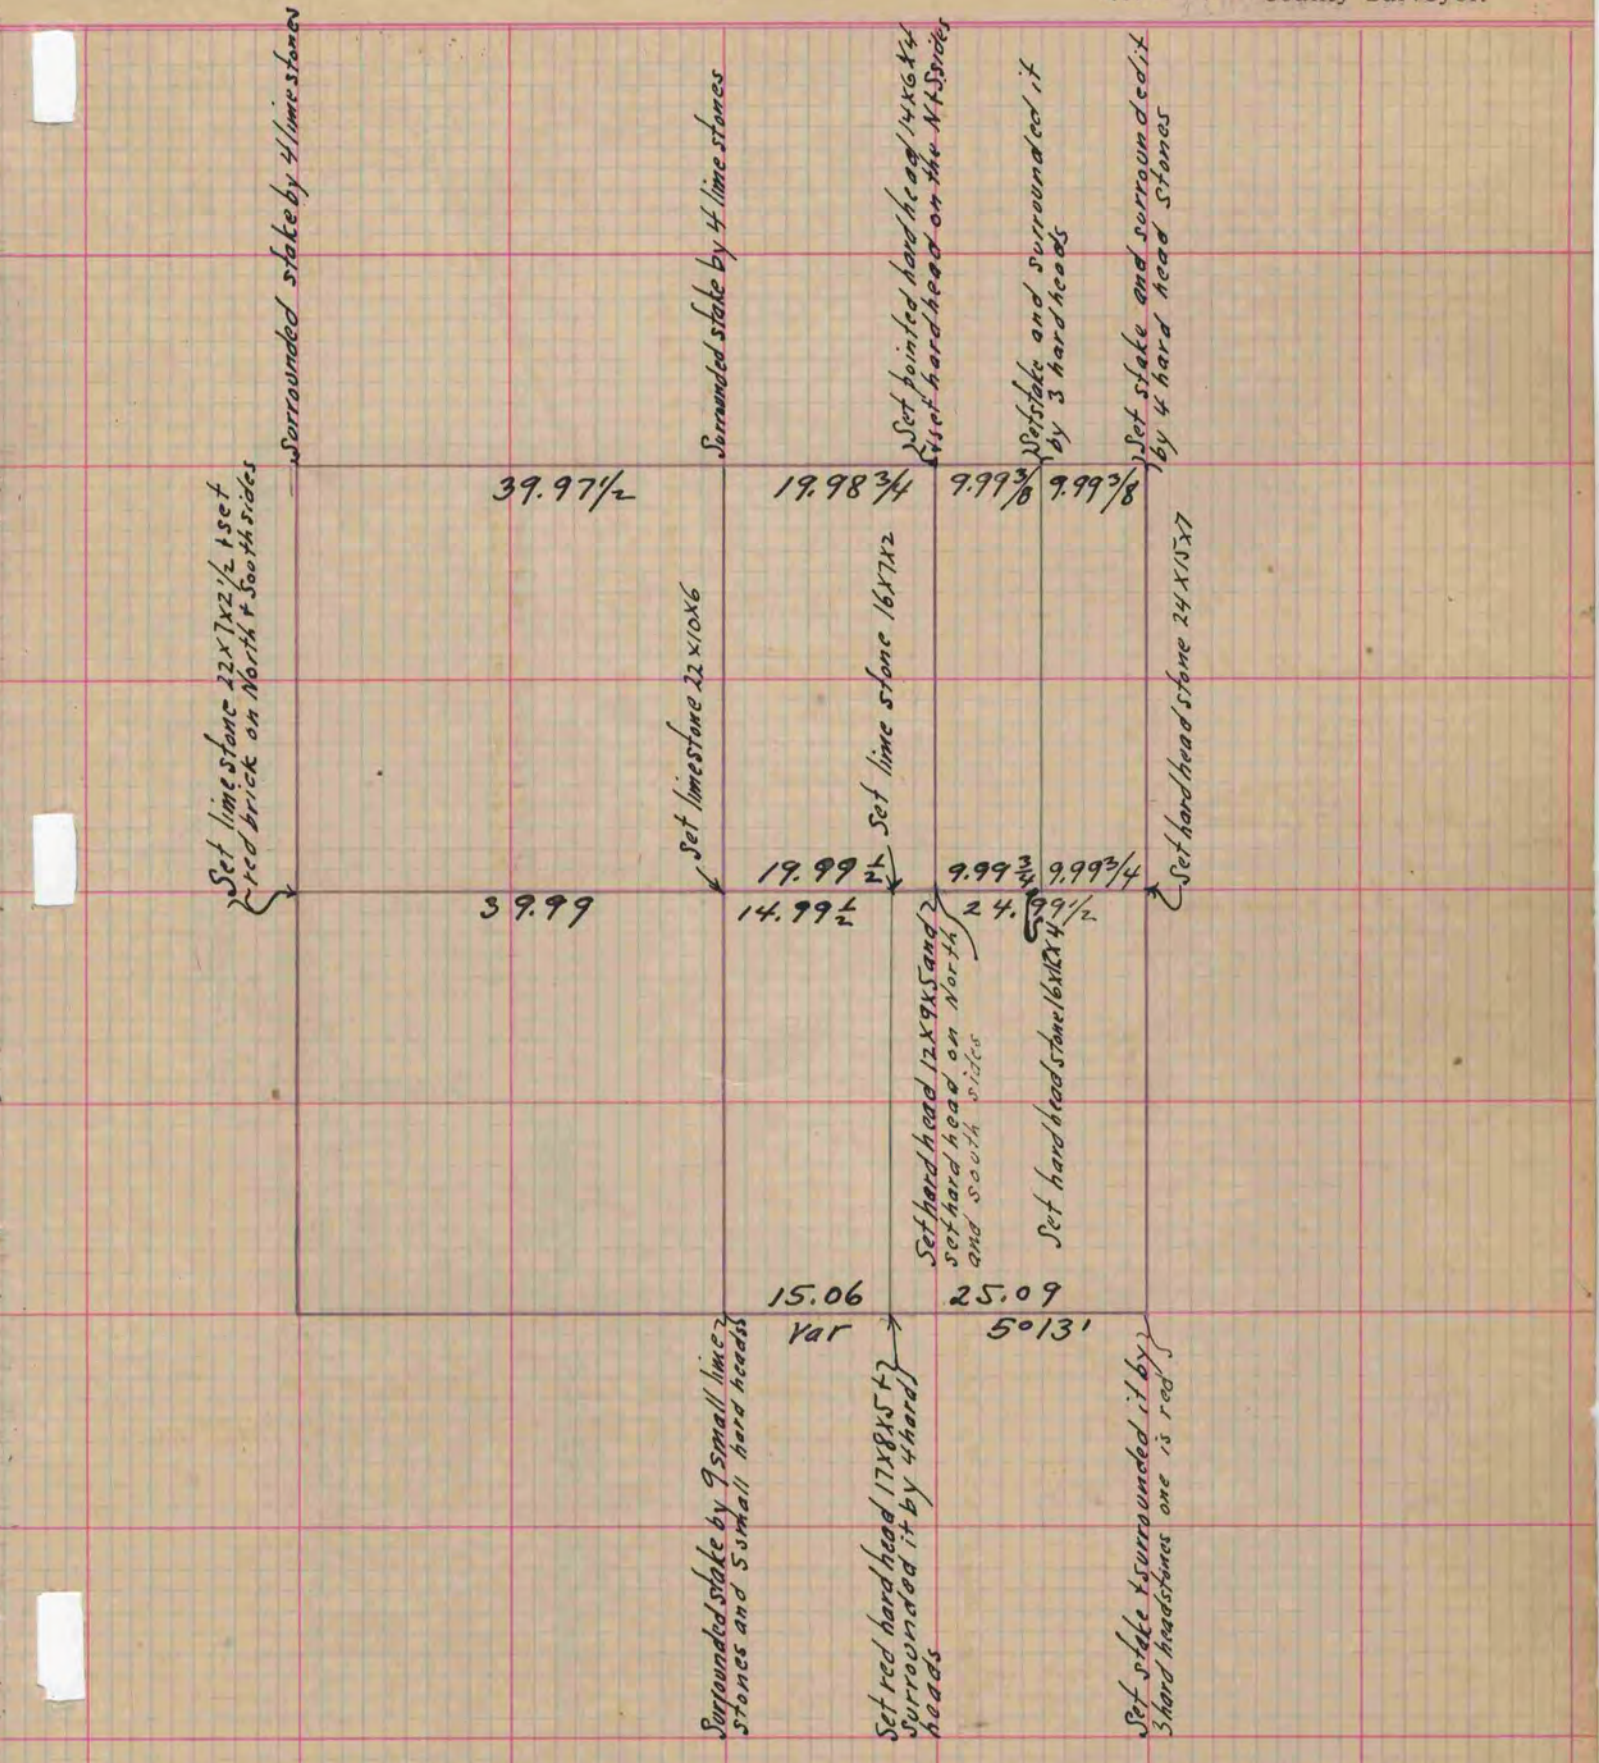

Copied from Page 176 Vol. One Original County Surveyors Record