

PLAT AND RECORD

MICROFILMED


COUNTY BUILDING
CITY OF JANESVILLE

Of a Survey on Section 17 T 2 R 13 E. of the 4 P. M. in La Prairie Township

Rock County, Wisconsin, made May the 2nd 1861

I hereby certify that the following is a correct record of said survey as made by me.

(Signed) Edward Ruger
R.H.B. County Surveyor.

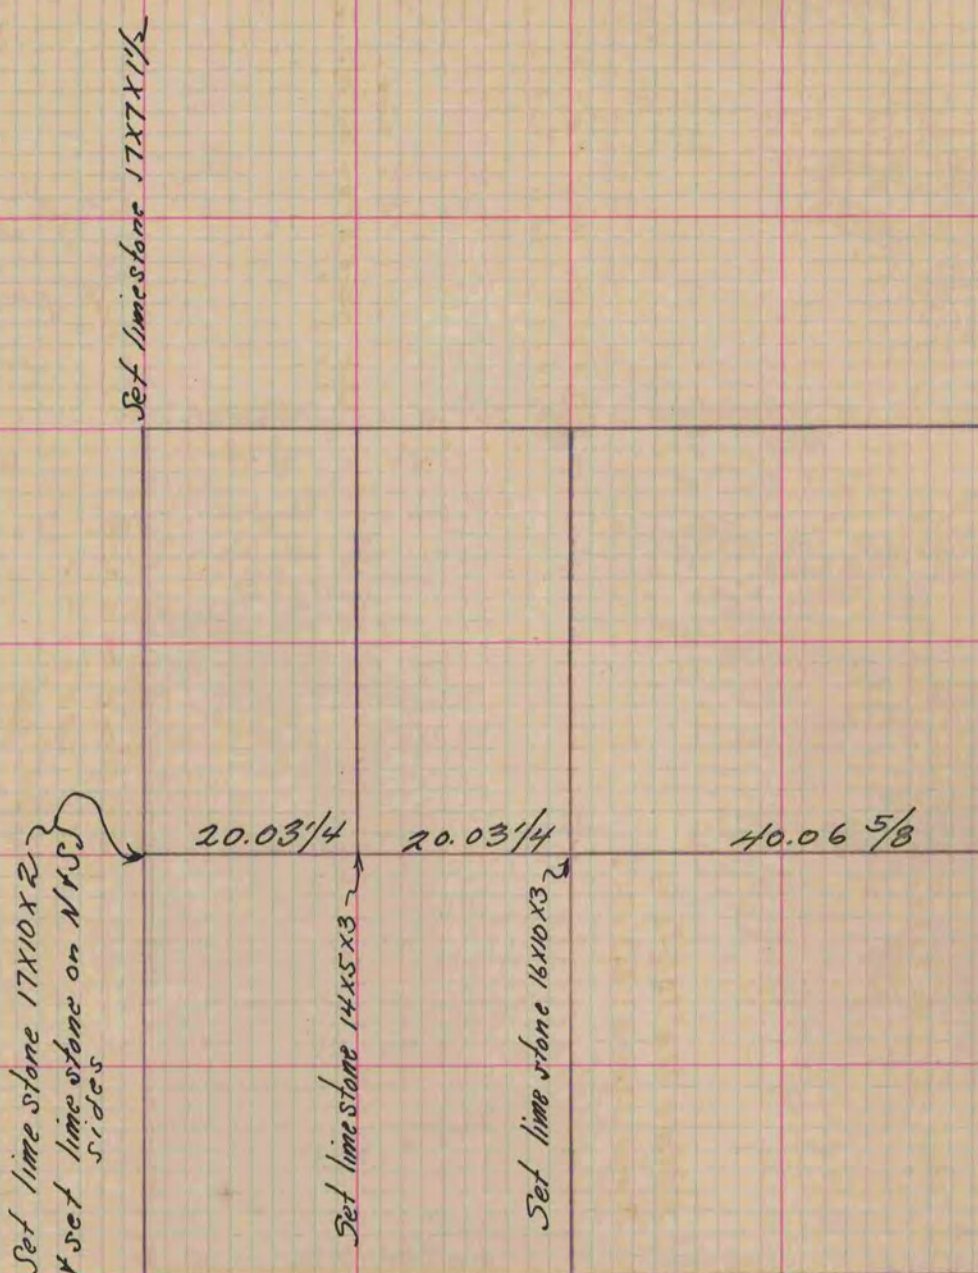

Copied from Page 170 Vol. One Original County Surveyors Record.