

PLAT AND RECORD

MICROFILMED


Of a Survey on Section 18 T 4 R 10 E. of the 4 P. M. in Union Township
Rock County, Wisconsin, made June the 4th 1861

I hereby certify that the following is a correct record of said survey as made by me.

COUNTY BUILDING
CITY OF JANESVILLE

(Signed) Edward Roger
R.H.B.

County Surveyor.

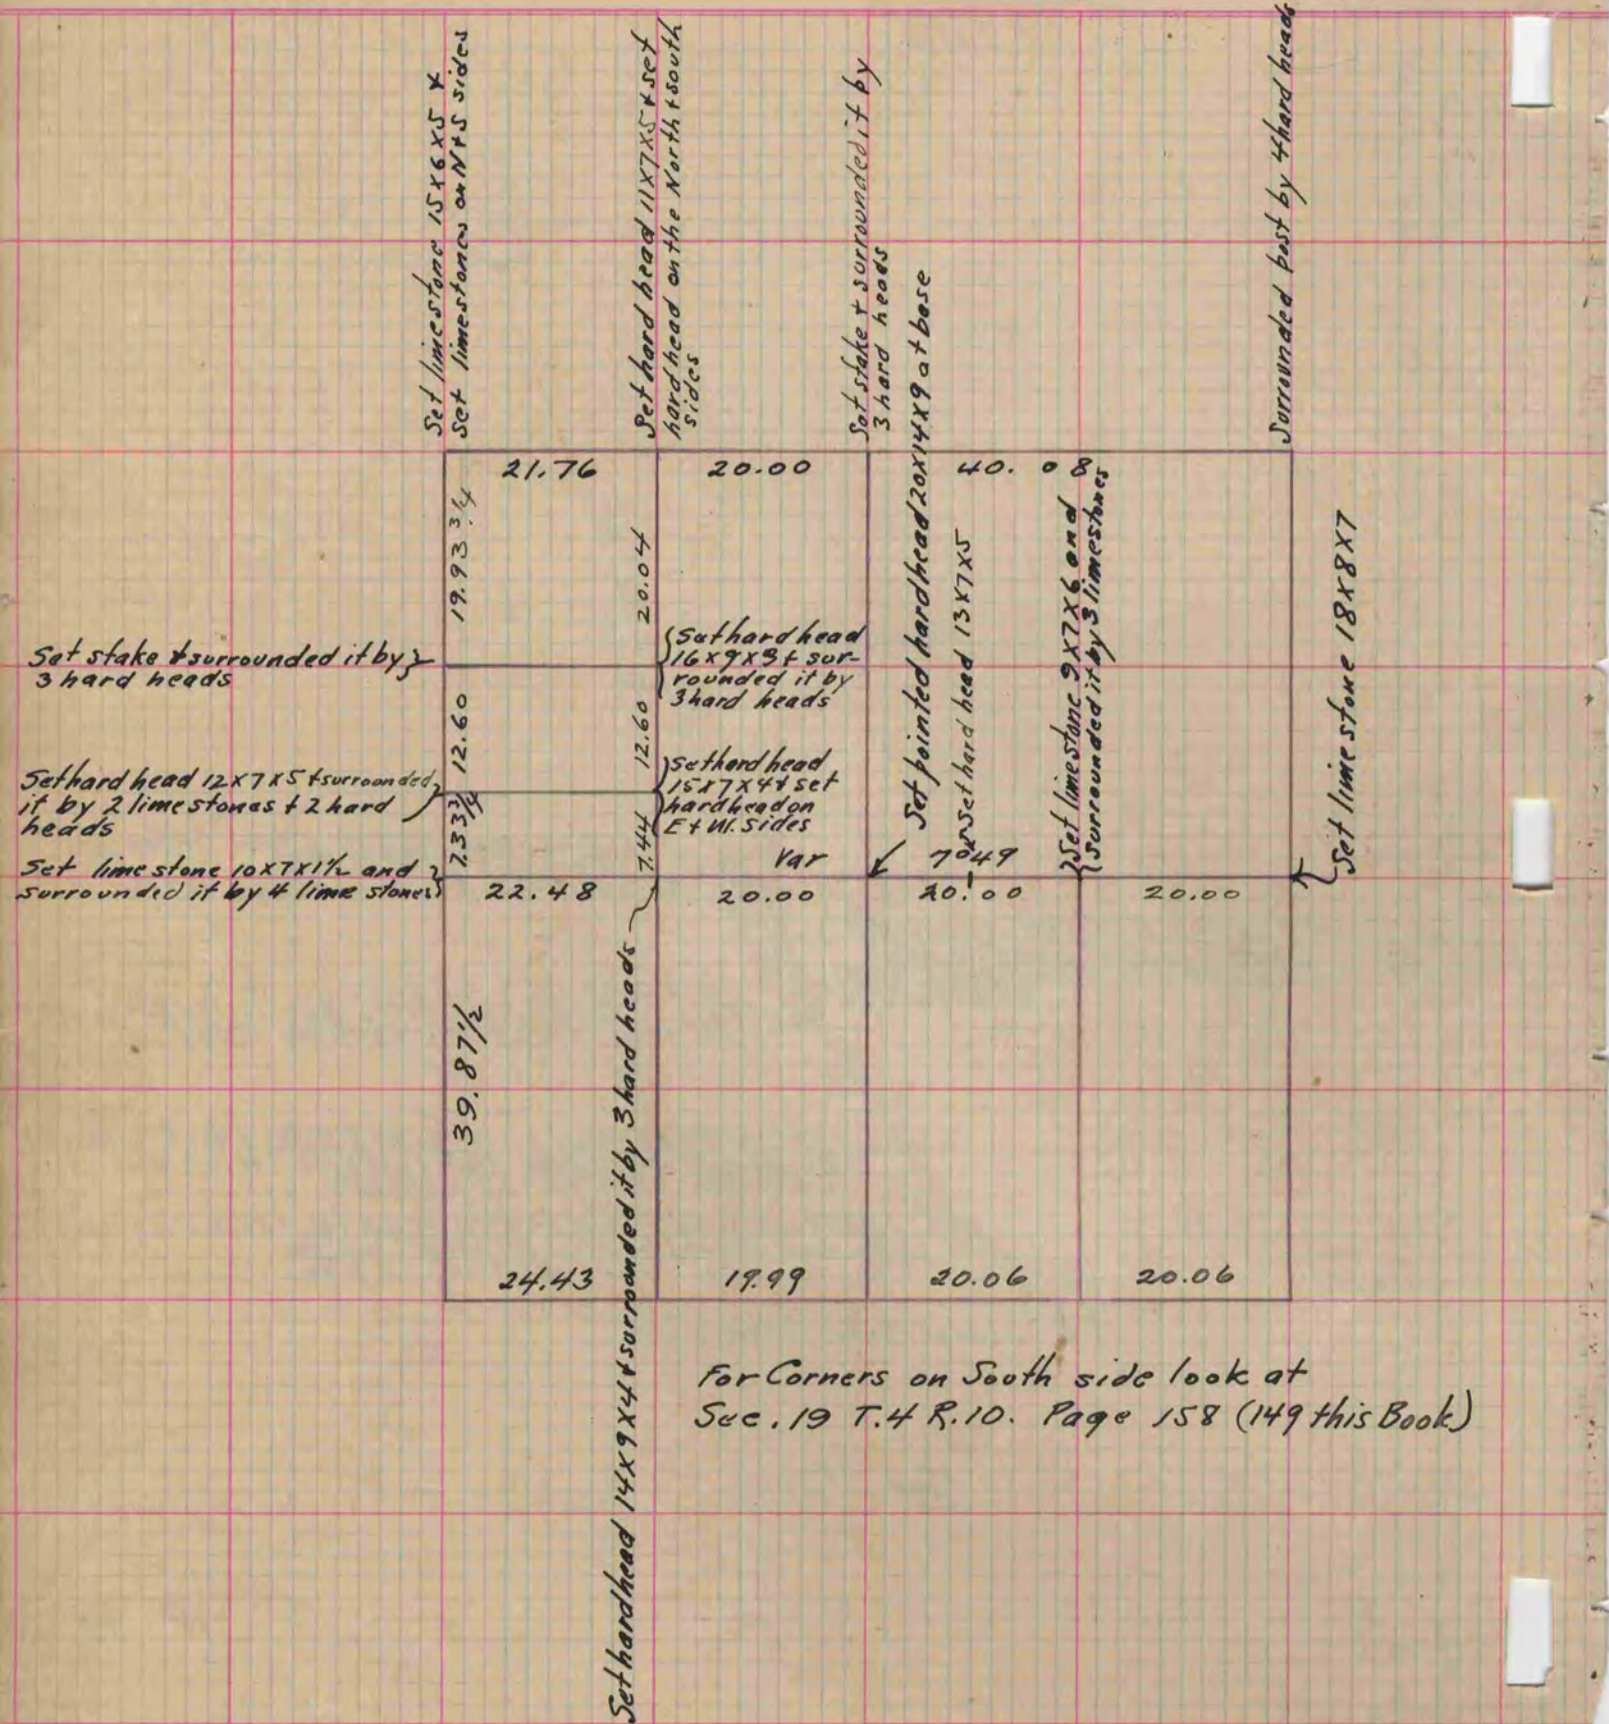

Copied from Page 175 Vol. One Original County Surveyors Record