

MICROFILMED

PLAT AND RECORD

169

V-1


COUNTY BUILDING
CITY OF JANESVILLE

Of a Survey on Section 30 T 3 R 14 E. of the 4 P. M. in Johnstown Township

Rock County, Wisconsin, made June the 18th 1861

I hereby certify that the following is a correct record of said survey as made by me.

(Signed) Edward Ruger
R. H. B. County Surveyor.

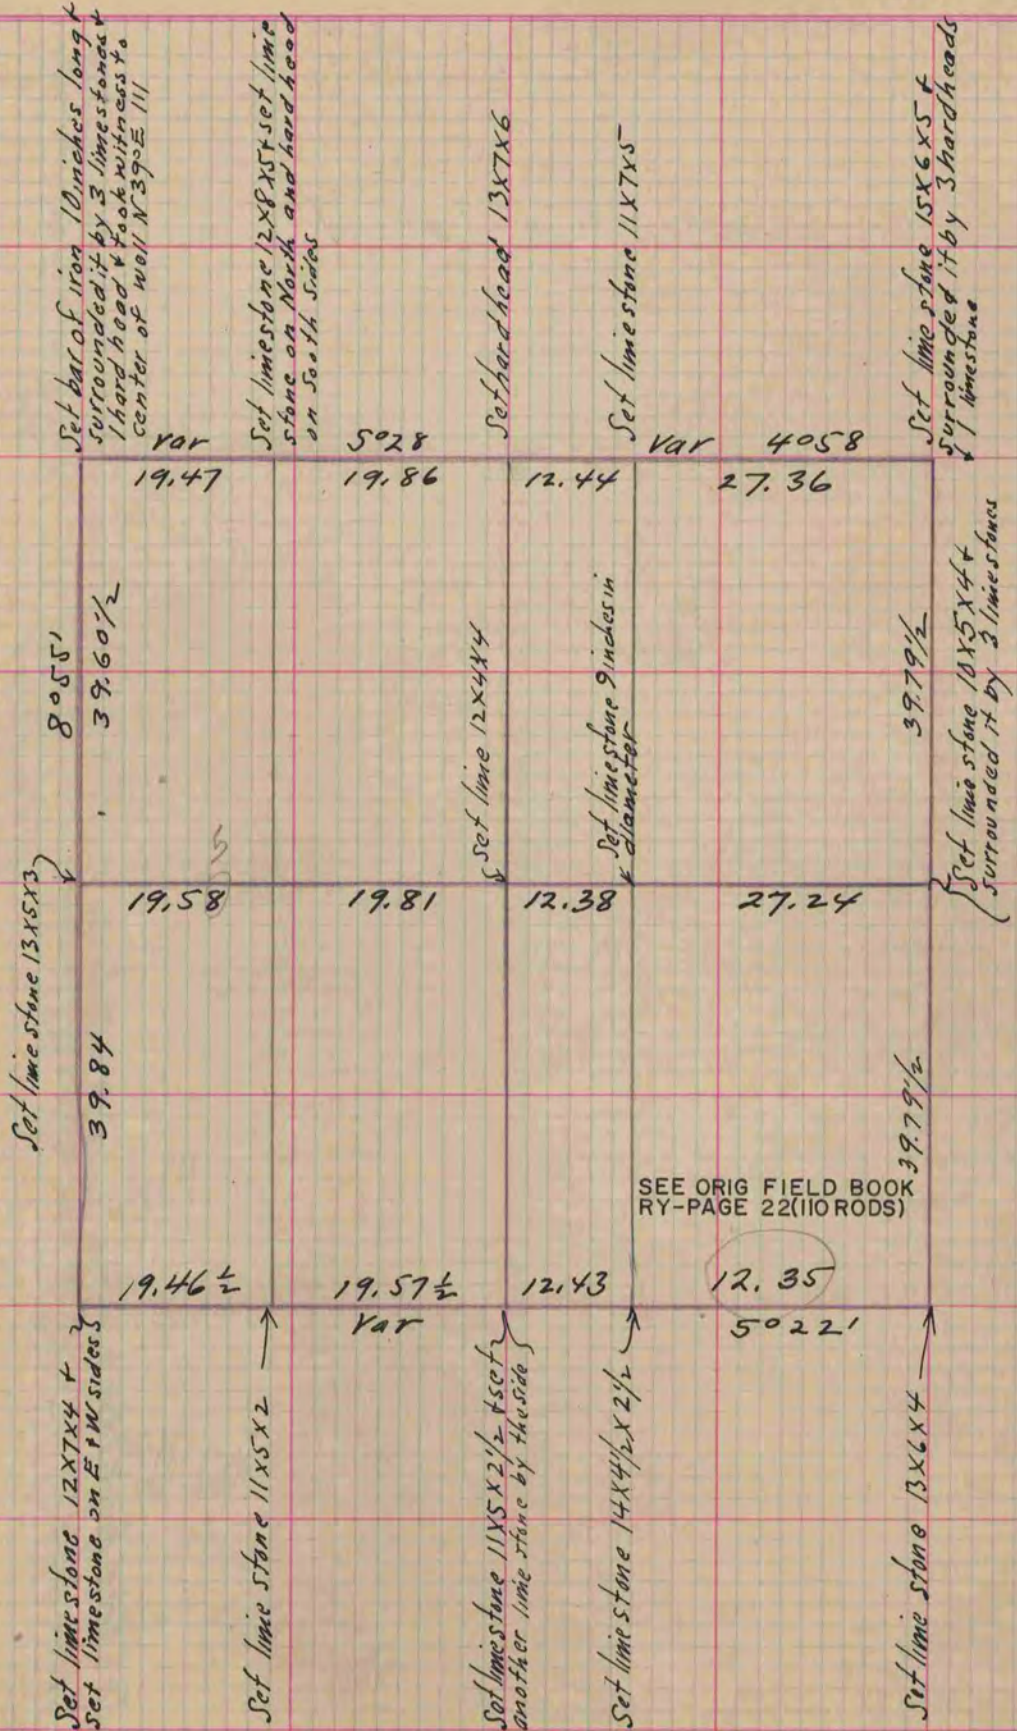

Copied from Page 178 Vol. One Original County Surveyors Record