

PLAT AND RECORD

VOL. 6


3, 23 2 12
34 T 3 R 12

Of a Survey on Section 34 Township 3 R 12 E. of the P. WISCONSIN JANESVILLE

Rock County, Wisconsin, made

I hereby certify that the following is a correct record of said survey as made by me.

COUNTY BUILDING
CITY OF JANESVILLE

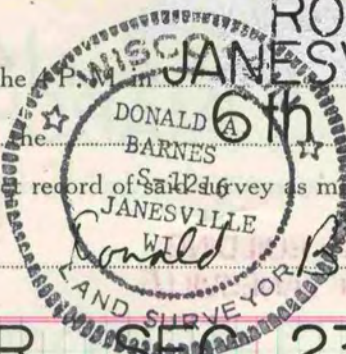

County Surveyor.

SW COR SEC 23

ROCK TWP

REPLACED 1" x 32" RE-ROD WITH ALUM
MON

N 1/4 COR SEC 3 Rock TWP

FOUND 2" IRON PIPE & TIES REPLACED WITH ALUM
MON ON TOP OF RECORD STONE

S 1/4 COR SEC 34

JANESVILLE TWP

FOUND 9" NAIL REPLACED WITH CAST IRON MON
ON TOP OF RECORD STONE

NW COR SEC 25

DAB 3/8/89

ROCK TWP

REPLACED 2" IP WITH ALUM MON

MICROFILMED