

PLAT AND RECORD

COUNTY BUILDING
CITY OF JANESVILLE

VOL. 5

Of a Survey on Section **6** T **3** R **10** E. of the 4 P. M. in **MAGNOLIA** Township

Rock County, Wisconsin, made **JULY** the **26** 19**78**


I hereby certify that the following is a correct record of said survey as made by me:



MICROFILMED

SW COR SEC 6

SET ALUM. MON. FROM TIES

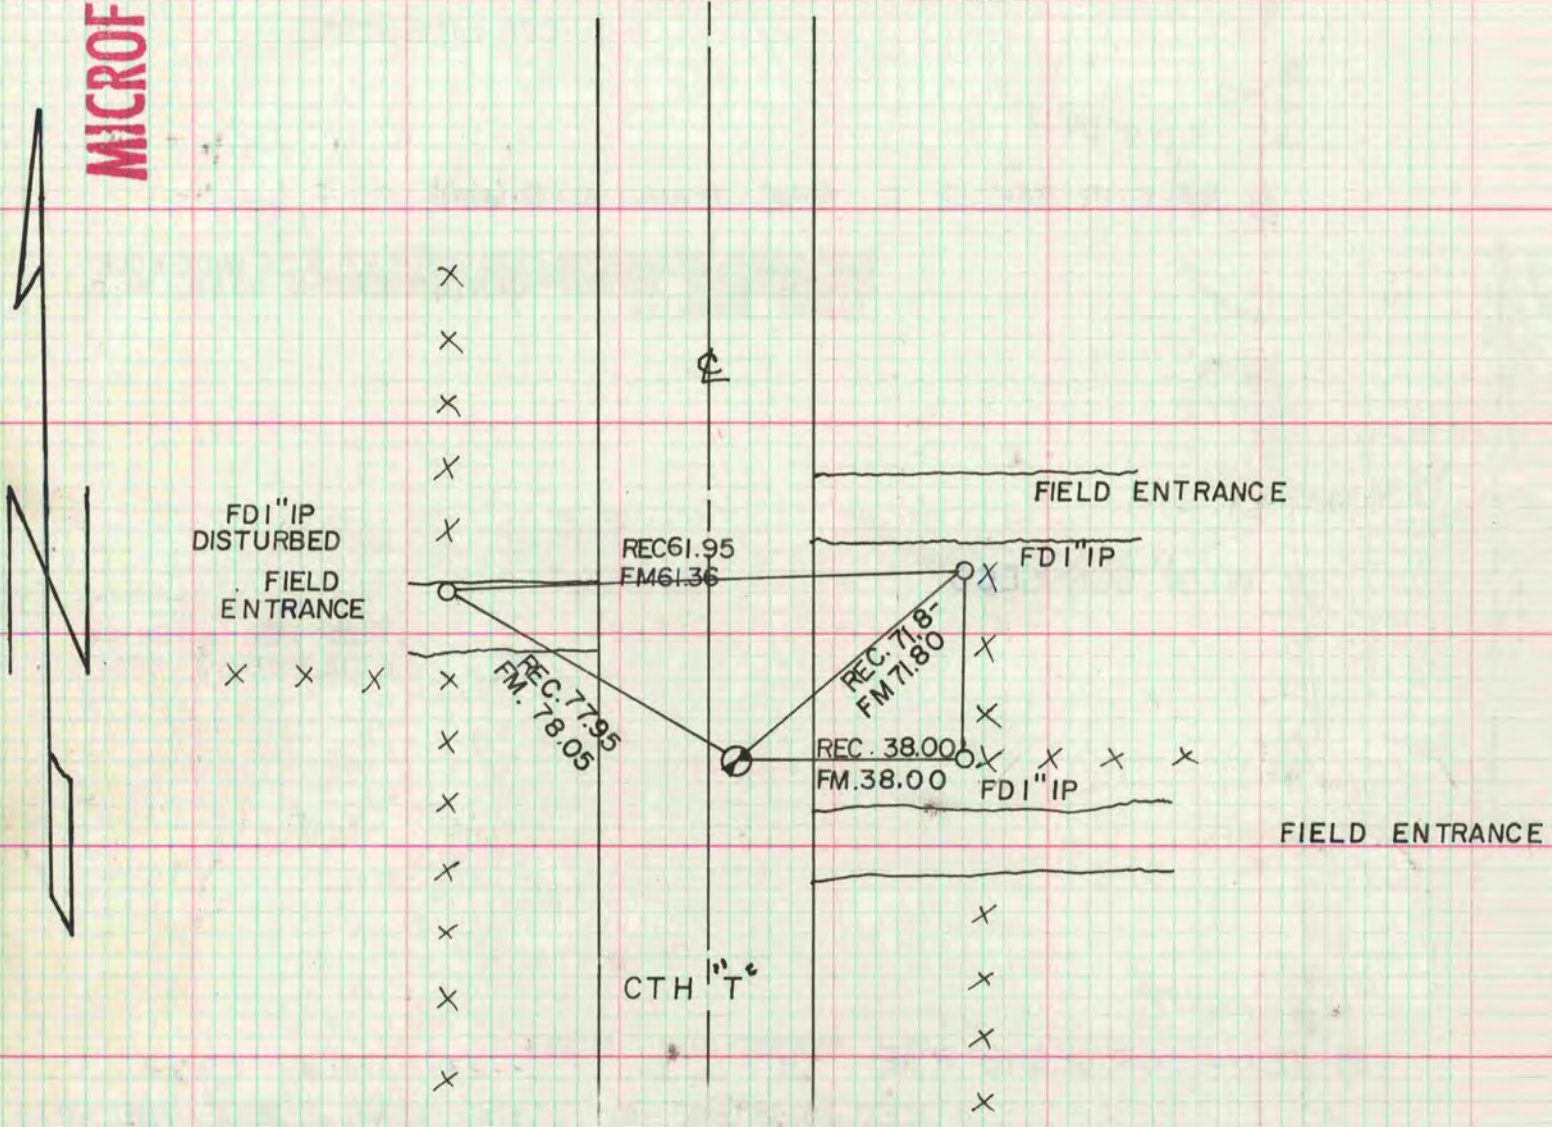

W1/4 COR SEC 6

W1/4 COR SEC 6 SET THE CORNER ON LINE WITH THE NE. COR. SEC. 12 & E1/4 COR. SEC. 12 GREEN COUNTY AND AT SINGLE PROPORTIONATE DISTANCE FROM THE NW & SW COR. OF SEC. 6 AS MEASURED BY LOCKE IN 1864. SET 30" ALUM MON ON TOP OF CULVERT. DUG & FOUND NOTHING

