

# PLAT AND RECORD

165  
VJ4

COUNTY BUILDING  
CITY OF JANESVILLE

1-2


Of a Survey on Section 11-12, 13-14 T. 3 N. R. 12 E. of the 4 P. M. in JANESVILLE Township

Rock County, Wisconsin, made NOVEMBER the 15 TH - 16 TH 1963

I hereby certify that the following is a correct record of said survey as made by me.

**MICROFILMED**

*Russell*  
County Surveyor.

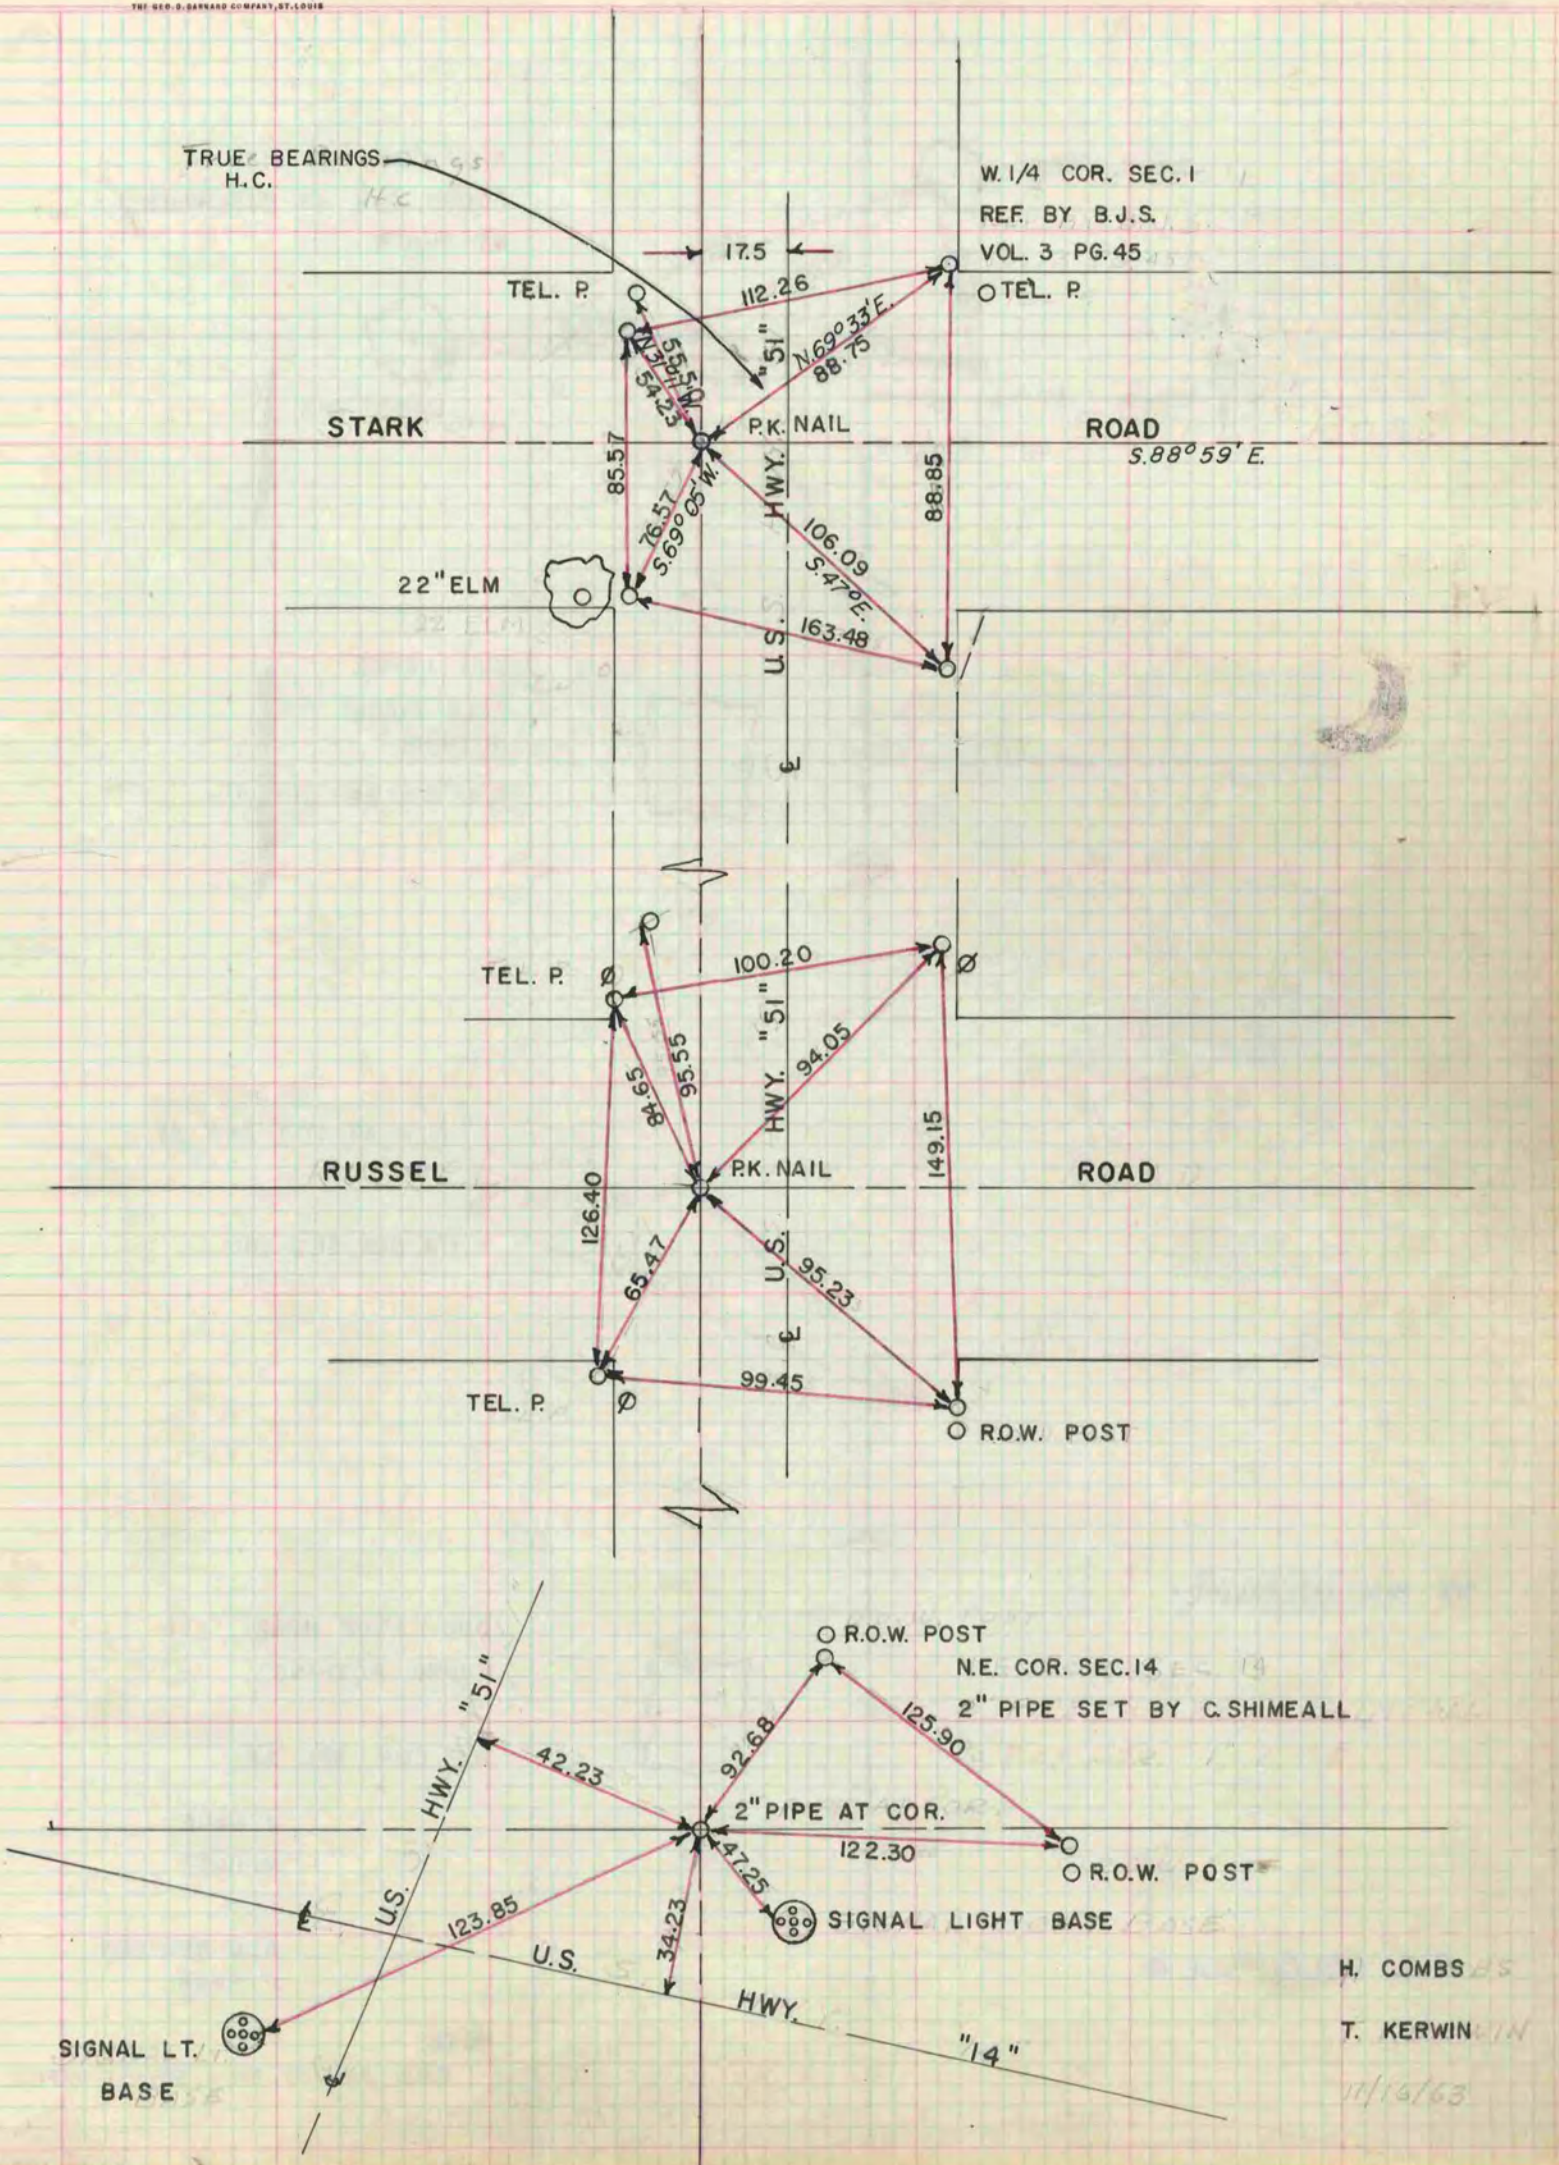

H. COMBS  
T. KERWIN  
11/14/63