

PLAT AND RECORD


VOL. 6

Of a Survey on Section **35** T **4** R **11** E. of the 4 P. M. in **PORTER** Township

Rock County, Wisconsin, made the


I hereby certify that the following is a correct record of said survey as made by me

COUNTY BUILDING
CITY OF JANESVILLE

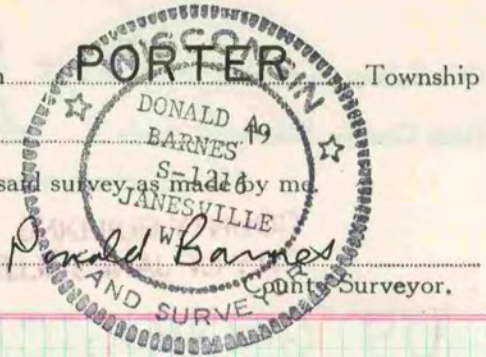

NW COR SEC 35

4' DEEP FOUND LIMESTONE & HARDHEAD, SET
ALUM MON

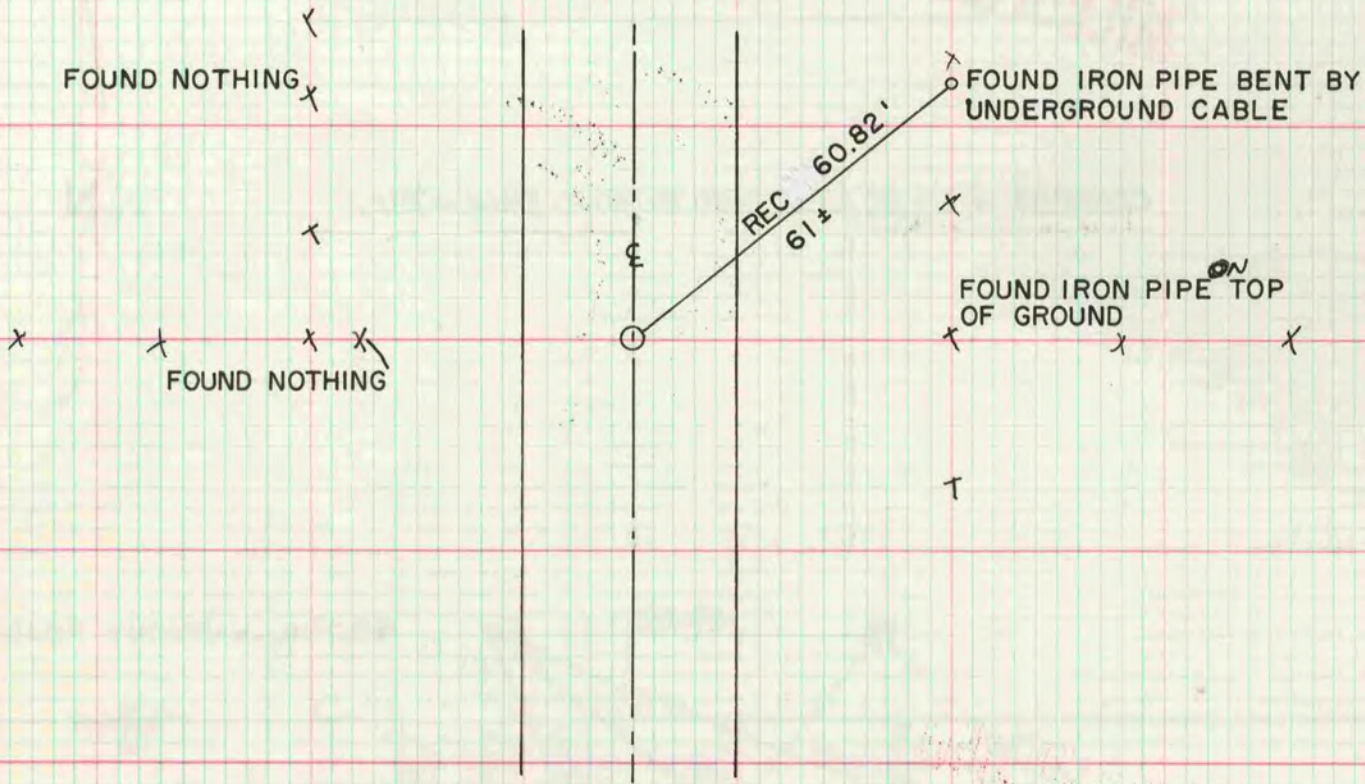

MICROFILMED